

Quitman
C 28
5-16-69

MISSISSIPPI
 BOARD OF WATER COMMISSIONERS
 416 North State Street
 Jackson, Mississippi 39201

CODED

WATER WELL DRILLERS LOG

5-16-69 date well completed Wile County Farmers Assn firm name Quitman county well located

LANDOWNER: MAHAN BROS
FALCON MISS
 (mailing address)

description of formations encountered	from	to
Buckshot TOP		1
Clay	1	28
Sand	28	33
Sand + Pearock	33	46
Gravel + Sand	46	108
Clay	108	115

WELL LOCATION: 2 miles NW of Falcon
 sec. 9 T. 29 N. R. 10 E.
 (distance) (direction) (nearest town)

WELL PURPOSE: irrigation
 (home, irrigation, municipal, industrial)

WELL COMPLETION DATA:

(1) diameter (inches) 16

(2) total depth (feet) 108'

(3) static water level (feet) 10 below above top of ground.

(4) casing Pipe 68
 (material) (depth)
16 if telescope see back.
 (size)

(5) screen 48' 68
 (length) (depth to top)
16 Open 101
 (size) (material)

(6) pump 70 2400
 (HP) (yield gpm)
Diesel
 (type power)

(7) electric log NO
 (yes or no)

(organization running log)

(8) how well bottom plugged Welded

CODED


MAY 20 1969

DRILLERS REMARKS:

MISS. BD. OF
 WATER COMMISSIONERS

If well telescopes please sketch and show depths.

GROUND LEVEL

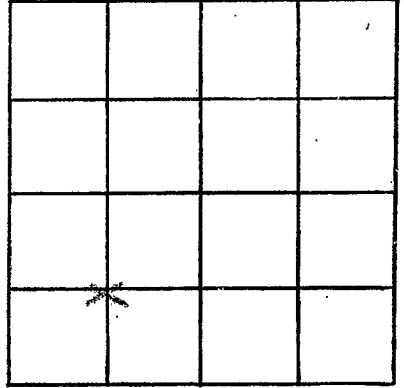

SECTION 9

Please indicate well location X.

ADDITIONAL INFORMATION

If more than one screen, show locations of each on sketch.