

Quitman
C 31
5-13-70

MISSISSIPPI
BOARD OF WATER COMMISSIONERS
416 North State Street
Jackson, Mississippi 39201

CODED

3 CD WATER WELL DRILLERS LOG

5-13-70 19 Five Camp Drillers Quitman
date well completed firm name county well located

LANDOWNER: J. T. Gordon
Sledge, Miss.

description of formations encountered	from	to
<u>Clay</u>		<u>46</u>
<u>Shale</u>	<u>46</u>	<u>53</u>
<u>Sand - Shale</u>	<u>53</u>	<u>105</u>

(mailing address)

WELL LOCATION: 068
sec. 10 T29 S R-11 E
7 miles S.W. of Sledge
(distance) (direction) (nearest town)

WELL PURPOSE: Irrigation
(home, irrigation, municipal, industrial)

- WELL COMPLETION DATA:
- (1) diameter (inches) 6"
 - (2) total depth (feet) 105'
 - (3) static water level (feet) 12 below above top of ground.
 - (4) casing Pipe, 57'
(material) (depth)
6" if telescope see back.
(size)
 - (5) screen 48', 57'
(length) (depth to top)
6", Drives
(size) (material)
 - (6) pump 2 1/2 hp, 800
(HP) (yield gpm)
Tractor
(type power)
 - (7) electric log _____
(yes or no)
 - _____
(organization running log)
 - (8) how well bottom plugged Welded

CODED


JUN 8 1970

DRILLERS REMARKS:

MISS. RD. OF
WATER COMM.

If well telescopes please sketch and show depths.

GROUND LEVEL

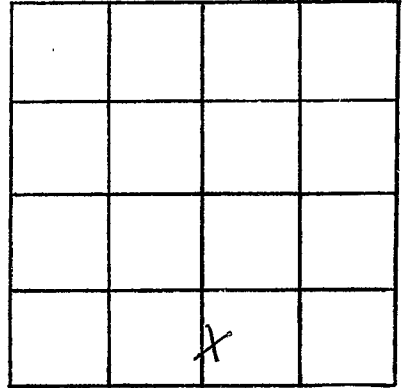

SECTION _____

Please indicate well location X.

ADDITIONAL INFORMATION

If more than one screen,
show locations of each on sketch.