

MISSISSIPPI
BOARD OF WATER COMMISSIONERS
416 North State Street
Jackson, Mississippi 39201

CODED

WATER WELL DRILLERS LOG

QUITMAN

Quitman
C35
1-67
GW-3383

1-10-# 1967 Five County Farmers Assn QUITMAN
date well completed firm name county well located

LANDOWNER: HD COX
RT 2 MARKS MISS

description of formations encountered	from	to
CLAY	0	20 1/2
FINE SAND		37 1/2
MED SAND		53
Coarse sand & gravel		105 1/2

(mailing address)


WELL LOCATION:
sec. 4 T. 95 S R. 10 E
7/8 miles East of Essex
(distance) (direction) (nearest town)

CODED

WELL PURPOSE: IRRIGATION
(home, irrigation, municipal, industrial)

WELL COMPLETION DATA:

- (1) diameter (inches) 6
- (2) total depth (feet) 125 1/2
- (3) static water level (feet) 16 below above top of ground.
- (4) casing 6" OD, 57 1/2"
(material) (depth)
6" if telescope see back.
(size)
- (5) screen 48', 57 1/2'
(length) (depth to top)
6", DOERT SCREEN
(size) (material)
- (6) pump 30 1200
(HP) (yield gpm)
Inactor
(type power)
- (7) electric log NO
(yes or no)

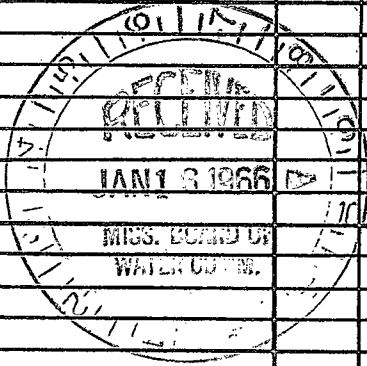

(organization running log)

(8) how well bottom plugged steel cap

DRILLERS REMARKS:

[Handwritten signature]

