

2/15/67
Jm

Quitman
C 36
1-67

MISSISSIPPI
BOARD OF WATER COMMISSIONERS
416 North State Street
Jackson, Mississippi 39201

WATER WELL DRILLERS LOG **CODED** C 2347R

January 14, 19 67 Layne-Central Company
date well completed firm name county well located

LANDOWNER: Self & Company

description of formations encountered	from	to
Clay	10	12
Fine sand	12	35
Coarse sand, fine pea gravel	35	78
Coarse sand and gravel	78	105
Big boulders	105	106


Marks, Mississippi
(mailing address)

WELL LOCATION:
sec 34 T 29 N S R 1 E W
5 miles N of Marks
(distance) (direction) (nearest town)

WELL PURPOSE: irrigation
(home, irrigation, municipal, industrial)

- WELL COMPLETION DATA:
- (1) diameter (inches) 16
 - (2) total depth (feet) 106
 - (3) static water level (feet) 151' below top of ground.
 - (4) casing steel, 56' (material), (depth), 16" (size) if telescope see back.
 - (5) screen 50' (length), 56' (depth to top), 16" (size), Armoc iron (material)
 - (6) pump (HP) (yield gpm) engine (type power)
 - (7) electric log no (yes or no) (organization running log)
 - (8) how well bottom plugged palte

CODED

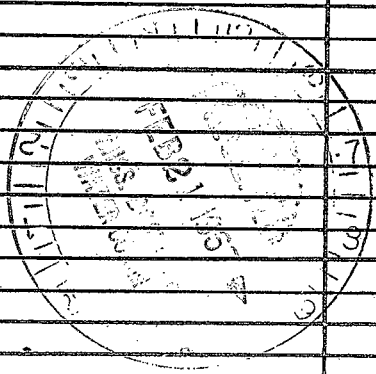

DRILLERS REMARKS:

If well telescopes please sketch and show depths.

GROUND LEVEL

X			

SECTION 34

Please indicate well location X.

ADDITIONAL INFORMATION

If more than one screen, show locations of each on sketch.