

MISSISSIPPI
BOARD OF WATER COMMISSIONERS
416 North State Street
Jackson, Mississippi 39201

CODED

WATER WELL DRILLERS LOG

Quitman
C37
5-67

5-5 1967 John Conely Jones Quitman
date well completed firm name county well located

LANDOWNER: John Ford
Essex Miss

description of formations encountered	from	to
<u>Top Soil</u>		<u>14</u>
<u>Fine sand</u>	<u>14</u>	<u>33 1/2</u>
<u>MBD sand</u>	<u>33 1/2</u>	<u>53</u>
<u>Coarse sand + gravel</u>	<u>53</u>	<u>124 1/2</u>

(mailing address)

WELL LOCATION:
sec. 16 T. 85 N R. 10 W
1 miles S of Falcons
(distance) (direction) (nearest town)

WELL PURPOSE: irrigation
(home, irrigation, municipal, industrial)

CODED


WELL COMPLETION DATA:

- (1) diameter (inches) 6
- (2) total depth (feet) 119 1/2
- (3) static water level (feet) 15-10 below above top of ground.
- (4) casing 6" Pipe, 71
(material) (depth)
- 6 if telescope see back.
(size)
- (5) screen 48', 71
(length) (depth to top)
- 6, Coen Screen
(size) (material)
- (6) pump 30, 1000
(HP) (yield gpm)
- Tractor
(type power)
- (7) electric log NO
(yes or no)

(organization running log)

(8) how well bottom plugged filled


DRILLERS REMARKS:

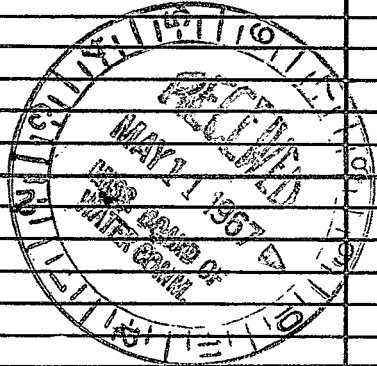

[Signature]

If well telescopes please sketch and show depths.

GROUND LEVEL

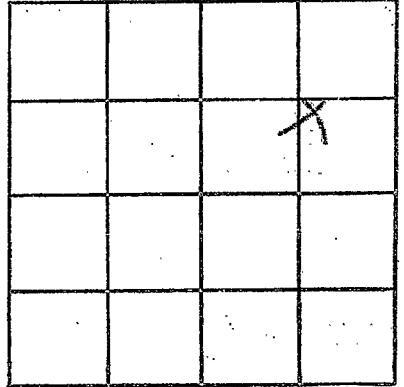

SECTION 16

Please indicate well location X.

ADDITIONAL INFORMATION

If more than one screen, show locations of each on sketch.