

**QUITMAN**  
**C 39**  
**9-6-74**  
**Elmer 24**  
**9/6**

**MISSISSIPPI**  
**BOARD OF WATER COMMISSIONERS**  
 416 North State Street  
 Jackson, Mississippi 39201

**WATER WELL DRILLERS LOG**

**CODED**

19 74 FIVE COUNTY FARMERS ASSN QUITMAN  
 date well completed firm name county well located

**LANDOWNER:** LESTON A. McARTHUR  
PO BOX JONESTOWN MISS

(mailing address)


**WELL LOCATION:**  
 sec. 30 T. 8 N. R. 10 E  
1/2 miles WEST of DARLING  
 (distance) (direction) (nearest town)

**WELL PURPOSE:**  
 (home, irrigation, municipal, industrial)

- WELL COMPLETION DATA:**
- diameter (inches) 4" x 2"
  - total depth (feet) 1342'
  - static water level (feet) 6 below top of ground. above
  - casing Galv Pipe, 1302'  
(material) (depth)  
4" x 2" if telescope see back.  
(size)
  - screen 40', 1302'  
(length) (depth to top)  
2", STAINLESS STEEL  
(size) (material)
  - pump 2 30  
(HP) (yield gpm)  
ELECTRIC  
(type power)
  - electric log YES  
(yes or no)  
USGS  
(organization running log)
  - how well bottom plugged BACKWASH  
VALVE

description of formations encountered	from	to
CLAY	0	40
SAND	40	180
CLAY	180	400
ROCK	400	410
BLUE CLAY	410	800
SAND	800	820
CLAY	820	1200
SAND	1200	1260
CLAY HARD	1260	1290
WATER BEARING SAND	1290	1346
CLAY	1346	1350

**CODED**

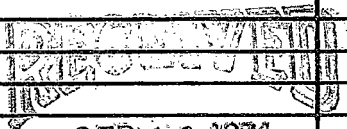

SEP 16 1974

**DRILLERS REMARKS:** WELL FLOWED  
11 GPM

MISS. BD. OF WATER COMMISSIONERS

