

C 40
 Quitman
 3/20/75

MISSISSIPPI
 BOARD OF WATER COMMISSIONERS
 416 North State Street
 Jackson, Mississippi 39201

CODED

WATER WELL DRILLERS LOG


3-26 1975 NORTH MISSWELL DRILL - Quitman
 date well completed firm name county well located

LANDOWNER: <u>Bob Huegels</u> <u>Marker</u>	description of formations encountered	from	to
(mailing address)	<u>Clay</u>	<u>0</u>	<u>10</u>
WELL LOCATION: sec. <u>4</u> T. <u>10</u> N. R. <u>10</u> E. <u>2</u> miles <u>S-W</u> of <u>Sledge</u> (distance) (direction) (nearest town)	<u>Sand</u>	<u>10</u>	<u>30</u>
WELL PURPOSE: (home, irrigation, municipal, industrial)		<u>50</u>	<u>105</u>
WELL COMPLETION DATA:			
(1) diameter (inches) <u>6"</u>	<u>#2</u>		
(2) total depth (feet) <u>105</u>			
(3) static water level (feet) <u>10</u> below above top of ground.			
(4) casing <u>Plastic</u> , <u>105</u> (material) (depth)			
If telescope see back. (size)			
(5) screen <u>50</u> , <u>53</u> (length) (depth to top)			
<u>6</u> , <u>Slot Plastic</u> (size) (material)			
(6) pump <u>Cent</u> , <u>950</u> (HP) (yield gpm)			
<u>Joe Eag</u> (type power)			
(7) electric log <u>no</u> (yes or no)			
(organization running log)			
(8) how well bottom plugged <u>Plug</u>			
DRILLERS REMARKS:			

MISS. RD. OF WATER COMMISSIONERS
 MAY 27 1975

If well telescopes please sketch and show depths.

GROUND LEVEL

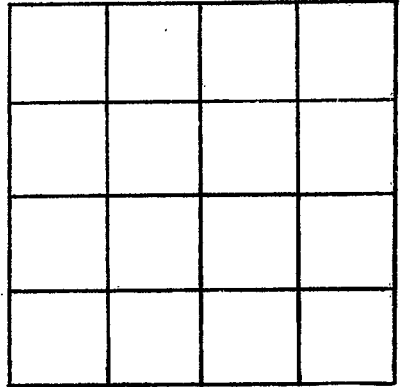

SECTION _____

Please indicate well location X.

ADDITIONAL INFORMATION

If more than one screen,
show locations of each on sketch.