

C 42
 Quitman
 3/26/75

MISSISSIPPI
 BOARD OF WATER COMMISSIONERS
 416 North State Street
 Jackson, Mississippi 39201

CODED

WATER WELL DRILLERS LOG

3-26-75 19 5 N - Miss Water Well Quitman
 date well completed firm name county well located

LANDOWNER: Bob Hueghe
Marks
 (mailing address)

description of formations encountered	from	to
<u>Blay</u>	0	15
<u>Sand</u>	15	53
<u>Clay</u>	53	110

WELL LOCATION:
 sec. 5 T 8 N R 10 E
2 1/2 miles S-W of Sledge
 (distance) (direction) (nearest town)

WELL PURPOSE: irrigation
 (home, irrigation, municipal, industrial)

WELL COMPLETION DATA:

(1) diameter (inches) 6"

(2) total depth (feet) 110

(3) static water level (feet) 9 below top of ground. above

(4) casing Plastic, 110
 (material) (depth)

(size) - If telescope see back.

(5) screen 50, 60
 (length) (depth to top)
6", Slot Plastic
 (size) (material)

(6) pump ✓ ✓
 (HP) (yield gpm)


(type power)

(7) electric log no
 (yes or no)

(organization running log)

(8) how well bottom plugged Plug

DRILLERS REMARKS:

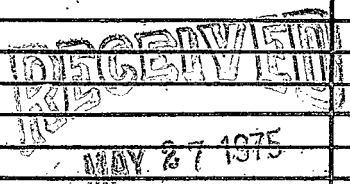


MISS. DE. OF WATER COMMISSIONERS

Open

If well telescopes please sketch and show depths.

GROUND LEVEL

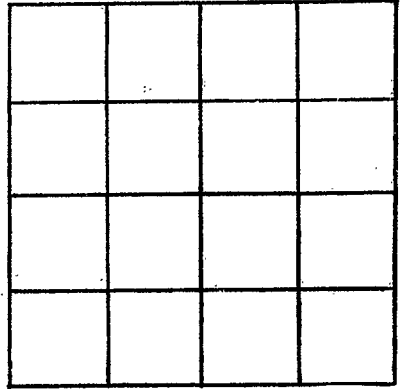

SECTION _____

Please indicate well location X.

ADDITIONAL INFORMATION

Well # 3 and # 4
100 feet apart

If more than one screen,
show locations of each on sketch.