

C 43
 Quitman
 3/28/75

MISSISSIPPI
 BOARD OF WATER COMMISSIONERS
 416 North State Street
 Jackson, Mississippi 39201

CODED

WATER WELL DRILLERS LOG

3-28 date well completed 1975 North Miss Well Drill - Quitman firm name county well located


LANDOWNER: Bob Huggins
Mark
 (mailing address)
 WELL LOCATION:
 sec. 5 T. 8 N. R. 18 E.
2 1/2 miles SW of Sledge
 (distance) (direction) (nearest town)

description of formations encountered	from	to
<u>Clay</u>	<u>0</u>	<u>12</u>
<u>Sand</u>	<u>12</u>	<u>60</u>
<u>Sand & Shale</u>	<u>60</u>	<u>120</u>

WELL PURPOSE: Irrigation
 (home, irrigation, municipal, industrial)

WELL COMPLETION DATA:
 (1) diameter (inches) 6"
 (2) total depth (feet) 120
 (3) static water level (feet) 10 below top of ground.
 (4) casing Plastic 120
 (material) (depth)
 (size) If telescope see back.
 (5) screen 50' 70
 (length) (depth to top)
6" Slot Plastic
 (size) (material)
 (6) pump ✓ ✓
 (HP) (yield gpm)
 (type power)
 (7) electric log NO
 (yes or no)
 (organization running log)
 (8) how well bottom plugged Plug

4

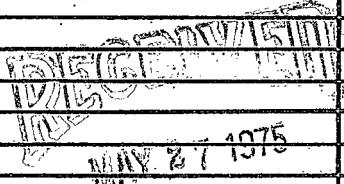


DRILLERS REMARKS:

MISS. Bd. OF WATER COMMISSIONERS

If well telescopes please sketch and show depths.

GROUND LEVEL

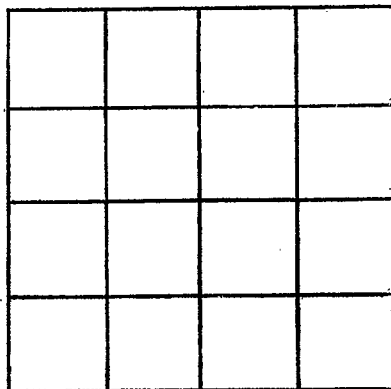

SECTION _____

Please indicate well location X.

ADDITIONAL INFORMATION

If more than one screen, show locations of each on sketch.