

#1

QUITMAN
C 45
9-2-76

MISSISSIPPI
BOARD OF WATER COMMISSIONERS
416 North State Street
Jackson, Mississippi 39201

CODED

WATER WELL DRILLERS LOG

Sep 2 1976 North Miss Well Drilling Quitman
date well completed firm name county well located


LANDOWNER: <u>Willie Jackson</u>	Description of formations encountered	from	to
(mailing address)	<u>Clay</u>	<u>0</u>	<u>10</u>
WELL LOCATION: sec. <u>35</u> T. <u>2</u> N. R. <u>10</u> E. <u>3</u> miles <u>S</u> of <u>Doak</u> (distance) (direction) (nearest town)	<u>sand</u>	<u>10</u>	<u>60</u>
WELL PURPOSE: (home, irrigation, municipal, industrial)	<u>Red Gravel & Sand</u>	<u>60</u>	<u>98</u>
WELL COMPLETION DATA:	CODED		
(1) diameter (inches) <u>2"</u>			
(2) total depth (feet) <u>98</u>			
(3) static water level (feet) <u>10</u> below above-top of ground.			
(4) casing <u>Plastic 98'</u> (material) (depth)			
_____ If telescope see back. (size)			
(5) screen <u>40'</u> (length) (depth to top)			
<u>8</u> <u>Blk Plastic</u> (size) (material)			
(6) pump <u>Cent-200 700</u> (HP) (yield gpm)			
<u>Tractor Pro</u> (type power)			
(7) electric log <u>No</u> (yes or no)			
_____ (organization running log)			
(8) how well bottom plugged <u>Plug</u>			
DRILLERS REMARKS:			

RECEIVED
SEP 27 1976

MISS. BD. OF WATER COMMISSIONERS

If well telescopes please sketch and show depths.

GROUND LEVEL

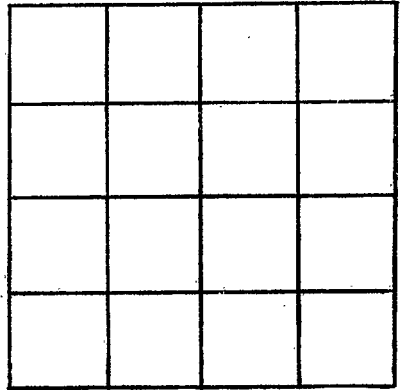

SECTION _____

Please indicate well location X.

ADDITIONAL INFORMATION

If more than one screen,
show locations of each on sketch.