

QUITMAN
C. 96
4-28-77

MISSISSIPPI
BOARD OF WATER COMMISSIONERS
416 North State Street
Jackson, Mississippi 39201

CODER

WATER WELL DRILLERS LOG

April 28 19 77 Layne Central Co. Quitman
date well completed firm name county well located

LANDOWNER:	description of formations encountered	from	to
Flaglake Farms Sledge, MS (mailing address)			
WELL LOCATION: sec. 16 T 8 S R 10 E W 3 miles South of Sledge (distance) (direction) (nearest town)	Med. Coarse Sand	30	73
	Coarse Sand & Gravel	73	80
	Gravel & Coarse Sand	80	102
	Fine Sand	102	104
WELL PURPOSE: Irrigation (home, irrigation, municipal, industrial)			
WELL COMPLETION DATA:			
(1) diameter (inches) 16"			
(2) total depth (feet) 104'			
(3) static water level (feet) 11' 5" below top of ground.			
(4) casing Steel, 54' (material) (depth) 16" If telescope see back. (size)			
(5) screen 50', 54' (length) (depth to top) 16" Stainless Steel (size) (material)			
(6) pump 60 3000 (HP) (yield gpm) diesel (type power)			
(7) electric log No. (yes or no) (organization running log)			
(8) how well bottom plugged Steel Pl.			
DRILLERS REMARKS:			


CODER

RECEIVED
JUN 23 1977

MISSISSIPPI WATER COMMISSION

If well telescopes please sketch and show depths.

GROUND LEVEL

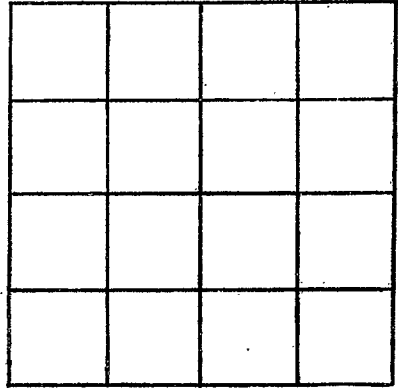

SECTION _____

Please indicate well location X.

ADDITIONAL INFORMATION

If more than one screen,
show locations of each on sketch.