

MISSISSIPPI DEPARTMENT OF NATURAL RESOURCES

Bureau of Land and Water Resources

Southport Mall

P.O. Box 10631

Jackson, Mississippi 39209

WATER WELL DRILLERS LOG

Quitman  
C 53  
4-2-81

COPIED

4-2 date well completed     GIN, Mc Well Drilling firm name     Quitman county well located

LANDOWNER: Bill Neighs  
 (mailing address)

description of formations encountered	from	to
<u>Clay</u>	<u>0</u>	<u>20</u>
<u>Sand</u>	<u>20</u>	<u>60</u>
<u>Gravel</u>	<u>60</u>	<u>100</u>

WELL LOCATION:  
 sec. 3 T 8 N R. 10 E  
1/4 miles S-W of Stodds  
 (distance) (direction) (nearest town)

WELL PURPOSE: Domestic  
 (home, irrigation, municipal, industrial)

WELL COMPLETION DATA:

(1) diameter (inches) 8"

(2) total depth (feet) 100

(3) static water level (feet) 16 below top of ground.

(4) casing Plastic 100  
 (material) (depth)

\_\_\_\_\_ if telescope see back.  
 (size)

(5) screen 20 \_\_\_\_\_  
 (length) (depth to top)

8" \_\_\_\_\_  
 (size) (material)


(6) pump Zeebex 1000  
 (HP) (yield gpm)

Propane Engine  
 (type power)

(7) electric log NO  
 (yes or no)

\_\_\_\_\_ (organization running log)


(8) how well bottom plugged Cap

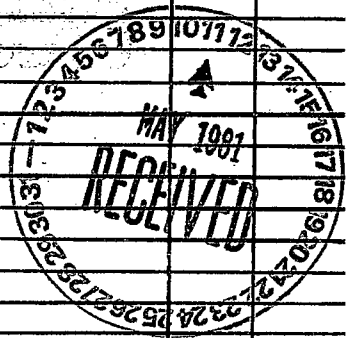

DRILLERS REMARKS: \_\_\_\_\_

If well telescopes please sketch and show depths.

GROUND LEVEL

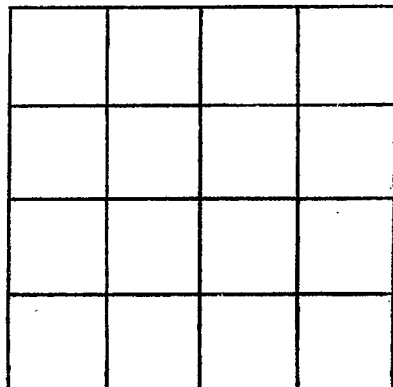

SECTION \_\_\_\_\_

Please indicate well location X.

ADDITIONAL INFORMATION

If more than one screen,  
show locations of each on sketch.