

MISSISSIPPI DEPARTMENT OF NATURAL RESOURCES

Bureau of Land and Water Resources

Southport Mall

P.O. Box 10631

Jackson, Mississippi 39209

WATER WELL DRILLERS LOG

Quitman
C 54
4-5-81

4-5-81
 date well completed

N. MS Well Drilling
 firm name

Quitman
 county well located

LANDOWNER: Bill Nugent

description of formations encountered

from

to

(mailing address)

WELL LOCATION:

sec. 3 T 8 N R 10 E
_{SW} _{WL}
1 miles S of Sledge
 (distance) (direction) (nearest town)

WELL PURPOSE: Irrigation
 (home, irrigation, municipal, industrial)

WELL COMPLETION DATA:

- (1) diameter (inches) 6"
- (2) total depth (feet) 110
- (3) static water level (feet) 15 below top of ground.
- (4) casing Plastic 110
 (material) (depth)

_____ if telescope see back.
 (size)

- (5) screen 40
 (length) (depth to top)
6" Slot Plastic
 (size) (material)

- (6) pump 1 1/2 450
 (HP) (yield gpm)


Electric
 (type power)

- (7) electric log No
 (yes or no)

_____ (organization running log)


- (8) how well bottom plugged Cap

DRILLERS REMARKS: _____

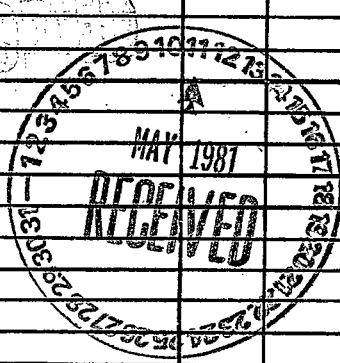

If well telescopes please sketch and show depths.

GROUND LEVEL

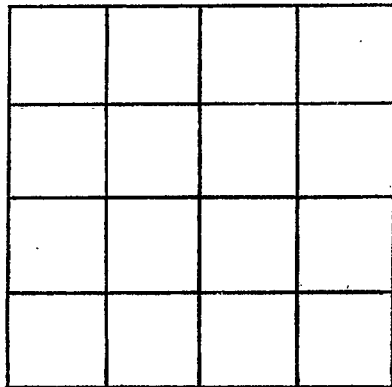

SECTION _____

Please indicate well location X.

ADDITIONAL INFORMATION

If more than one screen,
show locations of each on sketch.