

**MISSISSIPPI DEPARTMENT OF NATURAL RESOURCES**  
**Bureau of Land and Water Resources**  
 Southport Mall  
 P.O. Box 10631  
 Jackson, Mississippi 39209  
**WATER WELL DRILLERS LOG**

Quitman  
C 55  
4-12-81

4-12-81 date well completed     N. MS Well Drilling firm name     Quitman county well located

LANDOWNER: Junior Alderson

description of formations encountered	from	to
	<u>Clay</u>	<u>0</u>
<u>Sand</u>	<u>20</u>	<u>50</u>
<u>Gravel</u>	<u>50</u>	<u>90</u>

(mailing address)

WELL LOCATION:  
 sec. 5 T. 8 N. R. 10 E  
4 miles SW of Sledge  
 (distance) (direction) (nearest town)


WELL PURPOSE: Irrigation  
 (home, irrigation, municipal, industrial)

WELL COMPLETION DATA:

- (1) diameter (inches) 10"
- (2) total depth (feet) 90
- (3) static water level (feet) 13 below top of ground.
- (4) casing Plastic, 90 (material), (depth)  
 (size) if telescope see back.
- (5) screen 40 50 (length), (depth, to top)  
10", Slot Plastic (size), (material)
- (6) pump 20 Horse Head 1700 (HP), (yield gpm)  
Propair (type power)
- (7) electric log No (yes or no)  
 (organization running log)
- (8) how well bottom plugged Cap


DRILLERS REMARKS:

**PAID**

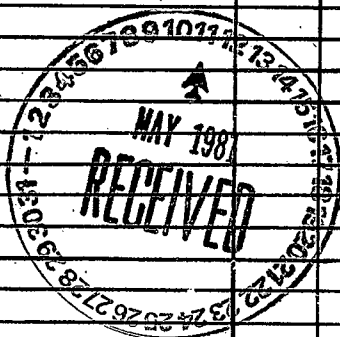

If well telescopes please sketch and show depths.

GROUND LEVEL

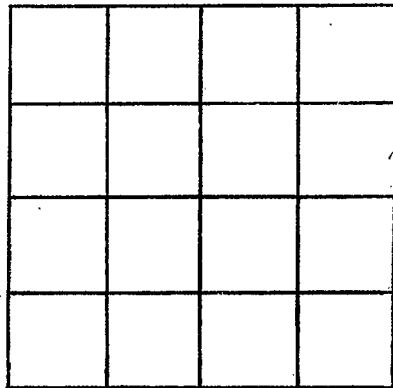

SECTION \_\_\_\_\_

Please indicate well location X.

ADDITIONAL INFORMATION

If more than one screen, show locations of each on sketch.