

MISSISSIPPI DEPARTMENT OF NATURAL RESOURCES

Bureau of Land and Water Resources

Southport Mall

P.O. Box 10631

Jackson, Mississippi 39209

WATER WELL DRILLERS LOG

CODED

*Quitman*

Quitman  
C56  
5-15-81

5-15-81 1981 Dyersville & Long Ser Quitman  
date well completed firm name county well located

LANDOWNER: Paul Jones

description of formations encountered

from to

Cidale, Miss  
(mailing address)

<u>Sam</u>	<u>12</u>	<u>23</u>
<u>Sam</u>	<u>23</u>	<u>33</u>
<u>Sam</u>	<u>33</u>	<u>43</u>
<u>Clay</u>	<u>43</u>	<u>53</u>
<u>Clay</u>	<u>53</u>	<u>63</u>
<u>Sam &amp; Gravel</u>	<u>63</u>	<u>73</u>
<u>Sam &amp; Gravel</u>	<u>73</u>	<u>83</u>
<u>Gravel</u>	<u>83</u>	<u>93</u>
<u>Gravel</u>	<u>93</u>	<u>103</u>
<u>Gravel</u>	<u>103</u>	<u>113</u>

WELL LOCATION:  
sec 34 T 8 N R 10 E  
2 miles NE of Essex  
(distance) (direction) (nearest town)

WELL PURPOSE:  
(home, irrigation, municipal, industrial)

WELL COMPLETION DATA:

- (1) diameter (inches) 16
- (2) total depth (feet) 113
- (3) static water level (feet) 15 below above top of ground.
- (4) casing Steel (material) (depth):  
16 if telescope see back. (size)
- (5) screen (length) (depth to top)  
40 (size) (material)
- (6) pump 40 (HP) 2000 (yield gpm)  
Diesel (type power)
- (7) electric log no (yes or no)  
(organization running log)

CODED




(8) how well bottom plugged Steel  
pipe

DRILLERS REMARKS:

If well telescopes please sketch and show depths.

GROUND LEVEL

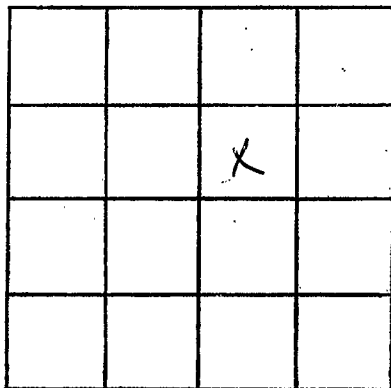

SECTION 34

Please indicate well location X.

ADDITIONAL INFORMATION

If more than one screen,  
show locations of each on sketch.