

Quitman  
 CS7  
 12/81

MISSISSIPPI  
 BOARD OF WATER COMMISSIONERS  
 416 North State Street  
 Jackson, Mississippi 39201

**CODED** ✓

WATER WELL DRILLERS LOG

December 19 **ROBERT E. RATLIFF CO.** *Quitman*  
 date well completed firm name county well located

LANDOWNER:  
*Town of Falcon*  
*Falcon, Mo.*  
 (mailing address)

description of formations encountered	from	to
<i>Top Soil</i>	0	8
<i>Sand &amp; gravel</i>	8	280
<i>Clay</i>	280	340
<i>Sand</i>	340	400
<i>Clay + sand</i>	400	460
<i>Sand</i>	460	500
<i>Sandy shale</i>	500	610
<i>Sand w/ clay lumps</i>	610	700
<i>Clay</i>	700	735
<i>Sand</i>	735	805
<i>Sand</i>	805	845
<i>Sand</i>	845	950
<i>Clay</i>	950	1290
<i>Clay</i>	1290	1330
<i>Clay</i>	1330	1420
<i>Sand</i>	1420	1520

WELL LOCATION:  
 sec. 16 T. 8 N. R. 10 E.  
 S W  
 10 miles 4 miles of Markes (nearest town)  
 (distance) (direction)

WELL PURPOSE:  
 (home, irrigation, municipal, industrial)

WELL COMPLETION DATA:

(1) diameter (inches) 6 x 4

(2) total depth (feet) 1520'

(3) static water level (feet) 12 below above top of ground.

(4) casing steel (material) 1460' (depth)  
 (size) if telescope see back.

(5) screen 60 (length) 1460 (depth to top)  
4 (size) Stainless Steel (material)

(6) pump 7 1/2 (HP) 100 (yield gpm)  
electric (type power)

(7) electric log Yes (yes or no)  
M & S (organization running log)

(8) how well bottom plugged BPT

DEPT. OF NATURAL RESOURCES  
 BUREAU OF LAND & WATER RESOURCES

FEB - 8 1982


**RECEIVED**

*Copy mailed*  
*Original 1/9/82*

DRILLERS REMARKS:

If well telescopes please sketch and show depths.

GROUND LEVEL

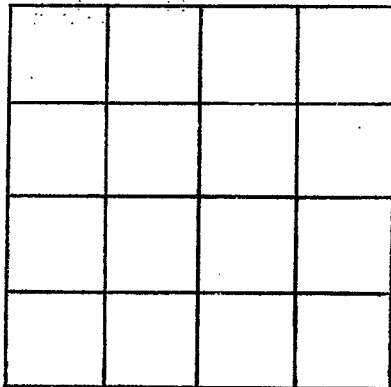

SECTION \_\_\_\_\_

Please indicate well location X.

ADDITIONAL INFORMATION

If more than one screen, show locations of each on sketch.