

MISSISSIPPI DEPARTMENT OF NATURAL RESOURCES

Bureau of Land and Water Resources

Southport Mall

P.O. Box 10631

Jackson, Mississippi 39209

WATER WELL DRILLERS LOG

**CODED**

C59  
 EL-2497 Quitman  
 7-6-83

7-6 1983 LAYNE CENTRAL CO. QUITMAN  
 date well completed firm name county well located

**LANDOWNER:**  
 SELF & COMPANY  
 MARKS, MS  
 (mailing address)

description of formations encountered	from	to
clay	0	20
coarse sand	20	52
coarse sand/gravel	52	116
clay /fine sand	116	118

**WELL LOCATION:**  
 sec. 35 T. 8 S. R. 10 W.  
 6 miles N of Marks  
 (distance) (direction) (nearest town)

**CODED**

**WELL PURPOSE:**  
 (home, irrigation, municipal, industrial)

**WELL COMPLETION DATA:**

(1) diameter (inches) 32"

(2) total depth (feet) 118'

(3) static water level (feet) 30' below top of ground.

(4) casing steel 66' (material), (depth)  
 16" (size) if telescope see back.

(5) screen 50' 66' (length), (depth to top)  
 16" steel (size), (material)

(6) pump (HP) (yield gpm)  
 (type power) N/A well only

(7) electric log no (yes or no)  
 (organization running log)

(8) how well bottom plugged st. plate

**DRILLERS REMARKS:**


DEPT. OF NATURAL RESOURCES  
 BUREAU OF LAND & WATER RESOURCES

OCT 10 1983

**RECEIVED**

If well telescopes please sketch and show depths.

GROUND LEVEL

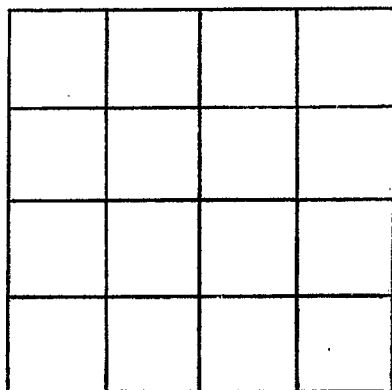

SECTION \_\_\_\_\_

Please indicate well location X.

ADDITIONAL INFORMATION

If more than one screen, show locations of each on sketch.