

MISSISSIPPI DEPARTMENT OF NATURAL RESOURCES

Bureau of Land and Water Resources

Southport Mall

P.O. Box 10631

Jackson, Mississippi 39209

WATER WELL DRILLERS LOG

C 60
 Quitman Co
 6-18-84

CODED

6/18 19 Rowell Irrigation Quitman
 date well completed firm name county well located

LANDOWNER: Fortner
 (mailing address)

description of formations encountered	from	to
Clay	0	20
Sand+Clay	20	40
Med Sand	40	60
Sand+Gravel	60	105

WELL LOCATION:
 sec. 24 T. 28 N. R. 11 E
3 miles new of Darlington
 (distance) (direction) (nearest town)

WELL PURPOSE: Irrigation
 (home, irrigation, municipal, industrial)

WELL COMPLETION DATA:

(1) diameter (inches) 12"

(2) total depth (feet) 105'

(3) static water level (feet) 15' below above top of ground.

(4) casing Steel 65'
 (material) (depth)

 if telescope see back.
 (size)

(5) screen 40' 65'
 (length) (depth to top)

12" Steel
 (size) (material)

(6) pump 40 2000
 (HP) (yield gpm)

diesel
 (type power)

(7) electric log NO
 (yes or no)

 (organization running log)

(8) how well bottom plugged FOR WATER

CODED

DEPT. OF NATURAL RESOURCES
 BUREAU OF LAND & WATER RESOURCES


JUL 10 1984

RECEIVED

DRILLERS REMARKS:

If well telescopes please sketch and show depths.

GROUND LEVEL

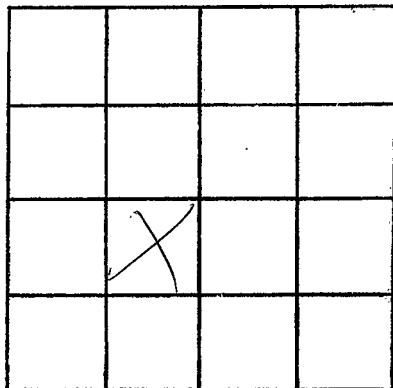

SECTION 24

Please indicate well location X.

ADDITIONAL INFORMATION

If more than one screen,
show locations of each on sketch.