

MISSISSIPPI DEPARTMENT OF NATURAL RESOURCES
 Bureau of Land and Water Resources
 Southport Mall
 P.O. Box 10631
 Jackson, Mississippi 39209
WATER WELL DRILLERS LOG

CODED

QUITMAN
 CI-2967 C61

4/12 19 85 LAYNE-CENTRAL CO. QUITMAN
 date well completed firm name county well located

LANDOWNER:
SELF & COMPANY
MARKS, MS
 (mailing address)

description of formations encountered	from	to
	clay	0
coarse sand	23	40
coarse sand/pea gravel	40	105
clay	105	

WELL LOCATION: #24
 sec. 14 T. 8 S. R. 10 E. W.
2 miles E of Falcon
 (distance) (direction) (nearest town)

CODED

WELL PURPOSE: irrigation
 (home, irrigation, municipal, industrial)

WELL COMPLETION DATA:

- (1) diameter (inches) 28"
- (2) total depth (feet) 100'
- (3) static water level (feet) 12' below above top of ground.
- (4) casing steel, 65'
 (material) (depth)
12" if telescope see back.
 (size)
- (5) screen 40', 65'
 (length) (depth to top)
12", st. steel
 (size) (material)
- (6) pump 40 1300
 (HP) (yield gpm)
diesel
 (type power)
- (7) electric log no
 (yes or no)
st. plate
 (organization running log)
- (8) how well bottom plugged st. plate


RECEIVED
 JUL 9 1985

DRILLERS REMARKS:

Department of Natural Resources
 Bureau of Land & Water Resources

If well telescopes please sketch and show depths.

GROUND LEVEL

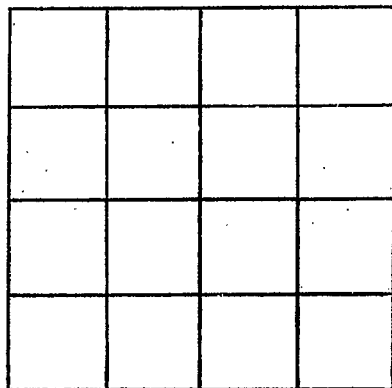

SECTION _____

Please indicate well location X.

ADDITIONAL INFORMATION

If more than one screen, show locations of each on sketch.