

C 1003

8-18-64

WATER WELL DRILLERS LOG

9/15/64
Jan 1865

Date: August 18, 1964, Driller: Layne-Central Company County Quitman

(Name)

(1) Owner of Land: Self & Company

(Name)

Marks, Mississippi

(Address)

At Darling

(2) Location: 1/4, 1/4, Sec. T. R.

 miles of Darling
(distance) (direction) (Nearest Town)

(3) Topography: flat

(Hilly) (Flat) (Level)

(4) Purpose of Well: Gin Fire Protection

(Domestic Irrigation
Municipal, Industrial, Other)

Description & Color of Materials Sand, Clay, Red Clay, Shell, etc.	Thick- ness Feet	Depth Feet
<u>Clay</u>	<u>15</u>	<u>15</u>
<u>Fine sand</u>	<u>5</u>	<u>20</u>
<u>Coarse sand</u>	<u>40</u>	<u>60</u>


Information upon completion of well:

- (1) Diameter 6 inches.
- (2) Total Depth 60 feet.
- (3) Water Level 14 feet below top of ground.
- (4) Cased to: 39', Size 6"
- (5) Screen: Size 6", Length 21'
- (6) Were any formations sealed against pollution?
 yes, no no.

If YES depth of formation

Why

Drillers Remarks:

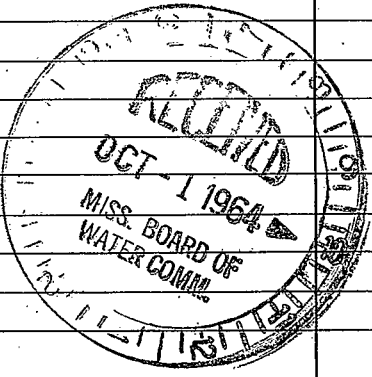

(Use Back Side)

Well No.

