

QUITMAN

C 2000

8-30-78

MISSISSIPPI BOARD OF WATER COMMISSIONERS
416 North State Street
Jackson, Mississippi 39201

WATER WELL DRILLERS LOG

Quitman
Bayman

8-30
date well completed

1978 J.B. Cain
firm name

Quitman
county well located

LANDOWNER: L. Bailey

Markes Miss

Po Box Markes Miss
(mailing address)

description of formations encountered

from

to

clumbo

0 10

sand

10 48

WELL LOCATION:

sec. 4 T28N R10E
S W
5 miles N-W of Markes
(distance) (direction) (nearest town)

WELL PURPOSE: D.I.M.
(home, irrigation, municipal, industrial)

WELL COMPLETION DATA:

- (1) diameter (inches) 4
- (2) total depth (feet) 48
- (3) static water level (feet) 10 below top of ground.
- (4) casing Plaster 48 (material) (depth)
- _____ if telescope see back. (size)
- (5) screen 10' 38' (length) (depth to top)
4" Plaster (size) (material)
- (6) pump 1 1/2 30 (HP) (yield gpm)
Elect (type power)
- (7) electric log _____ (yes or no)

(organization running log)

(8) how well bottom plugged

Wash/Bellon


RECEIVED
OCT 25 1978

DRILLERS REMARKS:

MISS. BD. OF WATER COMMISSIONERS

If well telescopes please sketch and show depths.

GROUND LEVEL

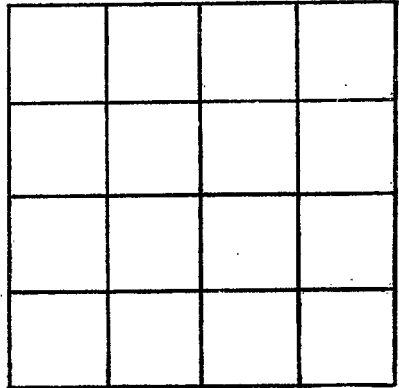

SECTION _____

Please indicate well location X.

ADDITIONAL INFORMATION

If more than one screen, show locations of each on sketch.