

QUITMAN MISSISSIPPI BOARD OF WATER COMMISSIONERS

D 11  
7-23-57

WATER WELL DRILLERS LOG

**CODED**

8/24/65  
C 400

Date: July 23, 1957, Driller: Layne-Central Company County Quitman

(Name)

- (1) Owner of Land: Self & Company  
(Name)  
Marks, Mississippi  
(Address)
- (2) Location: 1/4, 1/4, Sec. 22 T28R2W  
3 miles west of Belen  
(distance) (direction) (Nearest Town)
- (3) Topography: flat  
(Hilly) (Flat) (Level)
- (4) Purpose of Well: irrigation  
(Domestic Irrigation  
Municipal, Industrial, Other)

Description & Color of Materials Sand, Clay, Red Clay, Shell, etc.	Thick- ness Feet	Depth Feet
Top sandy soil	7	7
Clay	12	19
Coarse brown sand	13	32
Coarse sand & clay balls	10	42
Sand & pea rock	30	72
Sand & gravel	20	92
Sand & gravel	10	102
Sand rock	3	105
Sand & pea rock	13	118
Sand & began to fine up.	2	120

Information upon completion of well:

- (1) Diameter 18x12 inches.
- (2) Total Depth 120 feet.
- (3) Water Level 17'4" feet below top of ground.
- (4) Cased to 64', Size 18"  
5' of 18" x 12" swage
- (5) Screen: Size 12", Length 50'
- (6) Were any formations sealed against pollution?  
no yes, no no.


**CODED**

If YES depth of formation \_\_\_\_\_

Why \_\_\_\_\_

Drillers Remarks: \_\_\_\_\_  
2409 GPM.

Engine drive.

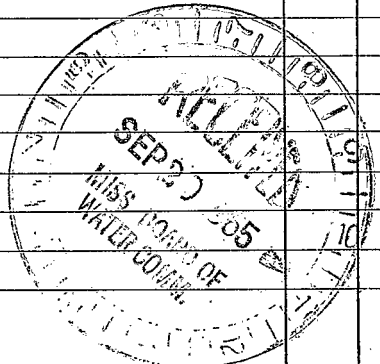

(Use Back Side)

Well No.

