

MISSISSIPPI DEPARTMENT OF NATURAL RESOURCES

Bureau of Land and Water Resources

Southport Mall

P.O. Box 10631

Jackson, Mississippi 39209

WATER WELL DRILLERS LOG

D 14
 Quitman
 2-22-84

CODED

2/22/84 19
 date well completed

Powell Irrigation
 firm name

Quitman
 county well located

LANDOWNER:
 Andy Carr
 Clarksdale, MS
 (mailing address)

description of formations encountered	from	to
Clay	0	13
Fine Sand & Clay	13	30
Coarse Sand	30	60
Coarse Sand & Gravel	60	100

WELL LOCATION: 2W
 sec. 14 T 28 N R 11 E
 S W
 2 1/2 miles NW of Belen
 (distance) (direction) (nearest town)

WELL PURPOSE: Irrigation
 (home, irrigation, municipal, industrial)

- WELL COMPLETION DATA:
- (1) diameter (inches) 12"
 - (2) total depth (feet) 100'
 - (3) static water level (feet) 16' below top of ground.
 - (4) casing steel, 60' (material), (depth)
 (size) if telescope see back.
 - (5) screen 40', 60' (length), (depth to top)
 12", steel (size), (material)
 - (6) pump 60 (HP), 1500 (yield gpm)
 Diesel (type power)
 - (7) electric log NO (yes or no)
 (organization running log)
 - (8) how well bottom plugged
 steel plate

DRILLERS REMARKS:


DEPT. OF NATURAL RESOURCES
 BUREAU OF LAND & WATER RESOURCES

MAR 23 1984

RECEIVED

If well telescopes please sketch and show depths.

GROUND LEVEL

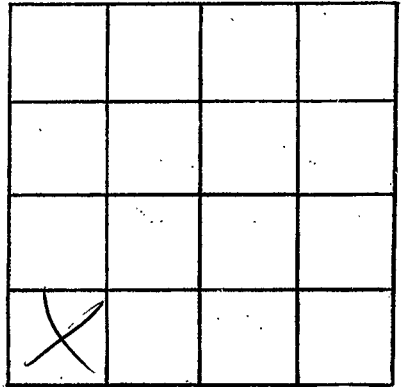

SECTION 14

Please indicate well location X.

ADDITIONAL INFORMATION

If more than one screen,
show locations of each on sketch.