

MISSISSIPPI DEPARTMENT OF NATURAL RESOURCES

Bureau of Land and Water Resources

Southport Mall

P.O. Box 10631

Jackson, Mississippi 39209

WATER WELL DRILLERS LOG

D15  
 EL-2656 QUITMAN  
 3-20-84

CODED

3-20-1984 date well completed      LAYNE CENTRAL CO. firm name      QUITMAN county well located

LANDOWNER:	description of formations encountered	from	to
SELF & COMPANY			
MARKS, MS	sand	20	40
(mailing address)	coarse sand	40	70
	coarse sand/gravel	70	122
WELL LOCATION: #1 of 2			
sec. 23 T. 28 N S R. 2 E W			
2 miles W of Belen			
(distance) (direction) (nearest town)			
WELL PURPOSE: irrigation			
(home, irrigation, municipal, industrial)			
WELL COMPLETION DATA:			
(1) diameter (inches) 28"			
(2) total depth (feet) 122'			
(3) static water level (feet) 14' below top of ground.			
(4) casing steel, 82' (material), (depth)			
12" (size) if telescope see back.			
(5) screen 40', 82' (length), (depth to top)			
12" (size), st. steel (material)			
(6) pump 40 (HP), 750 (yield gpm)			
diesel (type power)			
(7) electric log no (yes or no)			
(organization running log)			
(8) how well bottom plugged st. plate			

DRILLERS REMARKS:


DEPT. OF NATURAL RESOURCES  
 BUREAU OF LAND & WATER RESOURCES

MAY 17 1984

RECEIVED

If well telescopes please  
sketch and show depths.

GROUND LEVEL

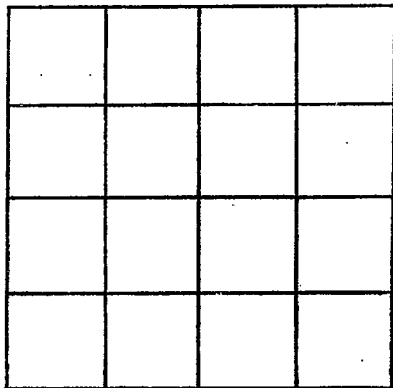

SECTION \_\_\_\_\_

Please indicate well location X.

ADDITIONAL INFORMATION

If more than one screen,  
show locations of each on sketch.