

MISSISSIPPI DEPARTMENT OF NATURAL RESOURCES

Bureau of Land and Water Resources

Southport Mall

P.O. Box 10631

Jackson, Mississippi 39209

WATER WELL DRILLERS LOG

Quimman
D 16
8/86

CODED

8/86 date well completed

POWELL IRRIGATION firm name

QUIMMAN county well located

LANDOWNER:
CARR HAUTING Co.
CLARKSDALE, MS 38614
 (mailing address)


description of formations encountered	from	to
CLAY	0	13
BROWN SAND	13	33
Blue CLAY	33	53
COARSE SAND	53	110
+ GRAVEL		

WELL LOCATION:
 sec. 14 T 28 N R. 2 E
3 miles NW of Belen
 (distance) (direction) (nearest town)

WELL PURPOSE: Irrigation
 (home, irrigation, municipal, industrial)

- WELL COMPLETION DATA:
- (1) diameter (inches) 16
 - (2) total depth (feet) 110
 - (3) static water level (feet) 14 below above top of ground.
 - (4) casing Steel 70
 (material) (depth)
 (size) if telescope see back.
 - (5) screen 40 70
 (length) (depth to top)
16 steel
 (size) (material)
 - (6) pump 60 2200
 (HP) (yield gpm)
diesel
 (type power)
 - (7) electric log NO
 (yes or no)

CODED

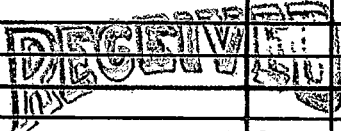

OCT 27 1986

Department of Natural Resources
 Bureau of Land & Water Resources


(organization running log)

(8) how well bottom plugged
Steel PLATE

DRILLERS REMARKS:

If well telescopes please
sketch and show depths.

GROUND LEVEL

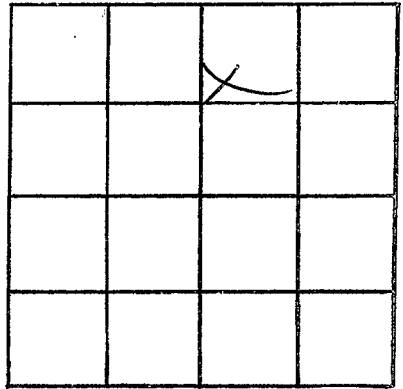

SECTION 14

Please indicate well location X.

ADDITIONAL INFORMATION

If more than one screen,
show locations of each on sketch.