

Part 2 never received
4/13
Switman

Job # 9149

County: Coahoma
 Permit #: GW43232
 Driller: Dea Sappington
 Date drilling completed: 5-12-09

State Well Report
Part 1 - Driller's Log
 Mississippi Department of Environmental Quality
 Office of Land and Water Resources
 P.O. Box 2309
 Jackson, MS 39225
 (601)981-5210
 (601)981-5228 (fax)

For Office Use Only:
 Aquifer: _____
 Well #: D37
 L. S. Elevation: _____
 E-log #: _____

State Law requires that this report be prepared by the license holder responsible for the work and filed with the Department at the above address within 30 days of completion of drilling of the well or borehole.

Information on Well Owner
 (Landowner if borehole is not for a water well)

Owner Name: Roe Farms
 Mailing Address: 245 East Lee Dr.
Clarksdale
MS 38614
 City State Zip Code
 Telephone No. 662 624 5863

Well or Borehole Location

Latitude 34° 16' 21.28" Longitude 90° 21' 28.16"
 Method of Lat/Long (circle one): Conventional Survey
 USGS quad, Hand-held GPS Survey-grade GPS
 SW $\frac{1}{4}$ SE $\frac{1}{4}$ Sec 24 Twn 28 N Rng 2 W
 Distance 1.4 Miles Direction N of Nearest Town BRLEN

Well / Borehole Data

Date drilling started: 5-12-09 Date drilling completed: 5-12-09 Hole depth: 100 Hole diameter: 16

Location of the source of any surface water used for drilling: Lake near well
 Method of dosing and volume of Chlorine used in drilling and development: Sodium Hypo Chlorite @ 10ppm

Logs run (circle all applicable): No log run Electric Gamma Ray Density Sonic Neutron
 Name of organization running log(s): _____

Purpose of borehole (check one): Water Well Geotechnical/Geological Investigation _____ Ground Source Heat Pump _____
 Seismic Survey _____ Other (describe) _____

If drilling is not related to water well construction, skip the remainder of this block

Purpose of Well (check one): Home _____ Industrial _____ Public Supply _____ Irrigation _____ Fish Culture _____ Other: _____

If a flowing well, method of flow regulation: Valve _____ Other (describe) _____

Static Water Level: 18 feet above or below (circle one) land surface Date measured: 5-12-09

Method of Measurement (circle one) steel tape electric tape air line other: _____

Well depth: 100 Well grouted to a depth of 10 feet Type of grout (circle one): Neat Cement Bestonic Mix

Casing length: 60 feet Casing diameter: 16 inches Type of casing: PVC

Screen length: 40 feet Screen diameter: 16 inches Type of screen: PVC

Screen slot size: 0.32 inches Setting depth: From 60 feet to 100 feet

Type of completion (circle all applicable): Gravel packed Underreamed Telescoped Open hole Natural Development
 Other (describe): _____

Top of lap pipe or reduction in casing: _____ feet. *If telescoped or more than one screen, describe on next page*


RECEIVED
 JUN 05 2009
 YMD JOINT WATER
 MANAGEMENT DISTRICT

Rept #
43232

The sketch below only required for water wells

If well telescopes, show depths on sketch.

Ground Level \rightarrow

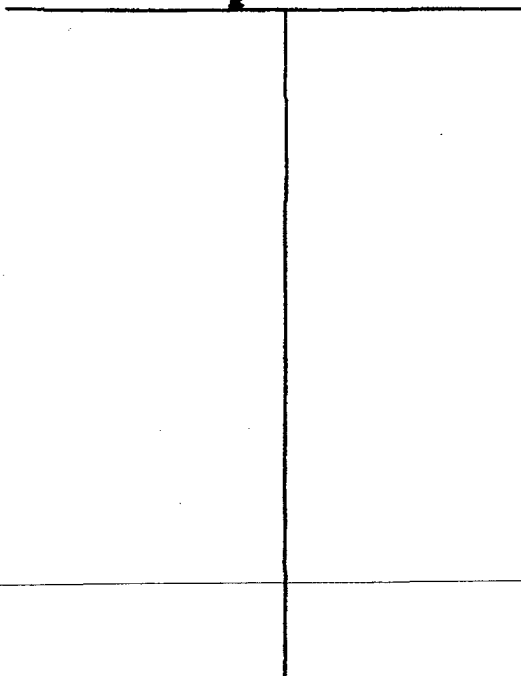


Description of formations encountered must be provided for all wells and boreholes, unless specifically exempted by regulations

Description of Formations Encountered	From (depth)	To (depth)
	Ground Level	
Clay	0'	40'
Sand	40'	80'
Coarse Sand & Gravel	80'	100'

If more than one screen, show location of each on sketch

Sketch the property layout and include the following: 1) the well location; 2) any permanent structures on the property that may aid in locating the well; 3) any roads, power lines, or other items that may aid in locating the property and the well; 4) a north arrow.

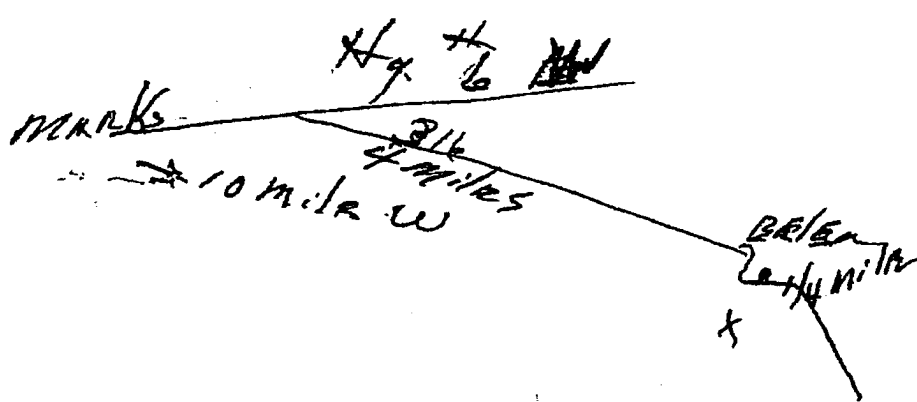

Landowner Name: JON VOIE

Form: OLWR-SWR-1A (04/08)

I certify that the well/borehole was drilled, constructed, and completed in accordance with all applicable requirements of the Mississippi Department of Environmental Quality and the Mississippi Department of Health regulations, if applicable, and state laws.

Print Name of Responsible Licensee and License No. DA30

Date 5-2-09

Signature of Licensee [Signature]