
Jate W	ell Report
$\lambda : 1 $ Part $-1$	Driller's Log
(ouni) Mississippi Departmer	nt of Environmental Quality Aquiter
Permit # (all) - 48 /01 Office of Land a	nd Water Resources
Driller Joel Jumper Jackson	, MS 39225
	901-0210 1.5009 (fox)
	1- 5228 (fax) E-log #
State Law requires that this report be prepared by the lic	ense holder responsible for the work and filed with the
Department at the above address within 30 days of comp	netion of drilling of the well or borehole.
Information on Well Owner	Well or Borehole Location
(Landowner if borehole is not for a water well) Owner Name	Latitude: 34 . 15 . 24 " Longitude: 90 . 24 . 11 -
	Method of Lat/Long (circle one): Conventional Survey.
Mailing Address: 150 Laney Ka	
Ĩ	LISGS guad, Hand-held GPS, Survey-grade GPS
LUDA ME BELAK	HAVE SHE 1/2 Sec 28 3 Twn 28N Rng Daw
Cit State Zip Code	Distance Direction Nearest Town
	Miles SE of Jonestown
Telephone No. ()	2
Weil / Bore	hole Data
Date drilling started: 42-15 Date drilling completed: 4-2-1	5 Hole depth: 115 Hole diameter: 2/in
Location of the source of any surface water used for drilling:	arest Well
Method of dosing and volume of Chlorine used in drilling and develo	
Logs run (circle all applicable): No log run Electric Gamma Ray Name of organization running log(s):	Density Sonic Neutron Other:
Purpose of borehole (check one): Water Well Geotechnical/Geolo	gical Investigation Ground Source Heat Pump
Seismic SurveyOther (describe) if drilling is not related to water well construction	skip the remainder of this block
Purpose of Well (check one): Home Industrial Public Supply	
If a flowing well, method of flow regulation: ValveOt	
Static Water Level: leet above or below circle one) la	nd surface Date measured: 2/-3-13
Method of Measurement (circle one) steel tape electric tape	air line other:
Well depth: <u>IIS</u> Well grouted to a depth of <u>D</u> feet Type of	of grout (circle one): Neat Coment (Bentonite) Mix
Casing length: 75 feet Casing diameter: 16	inches Type of casing:
Screen length: <u>40</u> feet Screen diameter: <u>16</u>	inches Type of screen:
Screen slot size: inches Setting depth: From	freet to 70 feet
Type of completion (circle all applicable): Gravel packed Underre	amed Telescoped Open hole Natural Development
Other (describe):	
Top of lap pipe or reduction in casing:feet. If teles	coped or more than one screen, describe on next page
	Form: OLWR-SWR-1A (04/08)

ę

A. A. A. Com and


## The sketch below only required for water wells

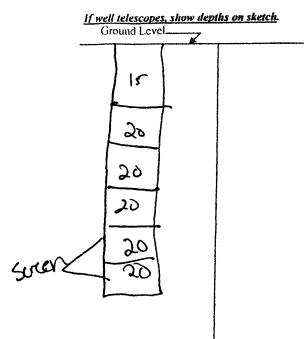

Descripti	an af fi	rmaii	ons en	countered	MUS	ne pr	oviu	gula	t uu	!
wells and	I borehe	vies, u	nless s	pecifically	exer	npred	<u>by re</u>		lion	! <u>\$</u>
							• .	-T		

Description of Formations Encountered		To (depth)
Gumbo	Ground Level	20
Sand	20	40
Course sand	40	60
grave + sanch	60	80
draw + sand	100	115
gian s		
		1
		1
		1
		<u> </u>
L1		L

If more than one screen, show location of each on sketch

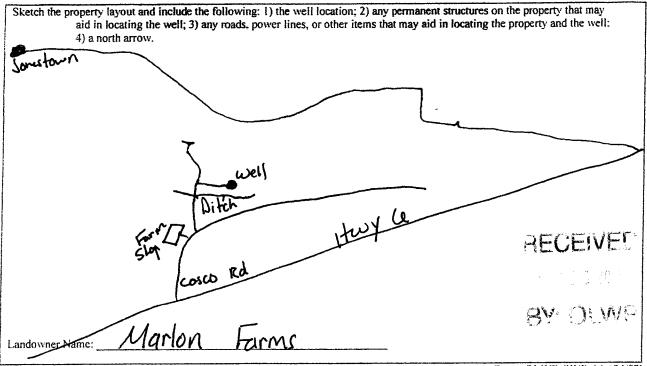

Form: OLWR-SWR-1A (04/08)

I certify that the well/borehole was drilled, constructed, and completed in accordance with all applicable requirements of the Mississippi Department of Environmental Quality and the Mississippi Department of Ilealth regulations, if applicable, and state

Date

laws. be Jumper

Signature of Licensee

Print Name of Responsible Licensee and License No.

Construction of the Constr				
•				
STATE W	ELL REPORT			
County:	Part 2 For Office Use Only:			
Mississippi Departu	er's Completion Report ment of Environmental Quality Well #: DUZ			
Driller: JOEL Jum ALR Office of La	nd and Water Resources			
Luare completed.	2.0. Box 2309 on, MS 39225-2309 Aquifer:			
	601)961-5210 ) 360-0535 (fax)			
	r well contractor, or a licensed pump installer. A copy of Part 1			
of the report must be attached and both parts filed with the 1	Department at the above address within 30 days of well completion.			
Well Owner Information	Well Location			
Owner Name: MARLON FARMS	Latitude: <u>340/5.241</u> Longitude: <u>90.24.11 "</u>			
Mailing Address: 150 LANEY RD	Method of Lat/Long (check one): Conventional Survey,			
	USGS quad, Hand-held GPS, Survey-grade GPS			
LYON MS 37645 City State Zip Code	NW 14_SW 14, Sec_28_T_28N_ROZW			
Telephone No. (do2) 624 - 6072	(Distance) (Direction) (Nearest Town)			
	pe (circle one)			
Submersible Turbine Air Lift Centrifugal Flowing Well	Jet Piston Rotary Other ( <i>describe</i> ):			
Date Pump Installed: <u>4-20-15</u>	Rated Pump Capacity:			
Is This Pump (circle one): New Repaired Replacement				
	pe (circle one)			
	dmill Other ( <i>describe</i> ):			
Horse Power Rating of Motor: <u><u>40</u> Setting Dept</u>				
Pump Test Data for Non Flowing Well				
Date Well Tested: Duration of Pump Test ( <i>minimum 4 hours</i> ): hours				
Static Water Level (A): Feet Below Land Surface Pumping Water Level (B): Feet Below Land Surface				
Drawdown [(B) - (A)]:Feet Below Land Surface Test Pumping Rate: Gallons Per Minute				
Method of measurement (circle one): Steel tape Electric tape Air line Other (describe):				
Pump Test Data for Flowing Well				
Measured shut in head:feet.				
Well yieldedGPM with a drawdown of	feet afterhours of pumping			
Meter	nstallation			
Meter Manufacturer:	Meter Serial Number:			
Meter Model Number/Name:	Type of Meter:			
Totalizer Register Unit and Multiplier Factor (AF x .001, gal x 1000, etc):				
Installation Date: Meter installed by:				
Is This Meter ( <i>circle one</i> ): New Repaired Replacement RECEIVED				
Important: By submitting the above information you are certifying that this meter was installed to manufacturer standards				
For agricultural wells, a list of app	proved meters is on the MDEQ website. MAY 8 2013			
I HEREBY CERTIFY that the above statements are true to the	e best of my knowledge.			
DAUED P. HOLT O-757P	5. 15-15 Jan Had			
Print Name of Pump Installer and License No. (if applicable)	Date Signature of Pump Installer			
	Form: OLWR-SWR-1B (4/13)			

•