

QUITMAN MISSISSIPPI BOARD OF WATER COMMISSIONERS

D 1002
8-14-64

WATER WELL DRILLERS LOG

9/25/64
JEC 1865

Date: August 14, 19 64, Driller: Layne-Central Company County Quitman


(Name)

- (1) Owner of Land: Self & Company
(Name)
Marks, Mississippi
(Address)
At Belen
(2) Location: 1/4, 1/4, Sec. T. R.
 miles of Belen
(distance) (direction) (Nearest Town)
(3) Topography: flat
(Hilly) (Flat) (Level)
(4) Purpose of Well: Gin Fire Protection
(Domestic Irrigation
Municipal, Industrial, Other)

Description & Color of Materials Sand, Clay, Red Clay, Shell, etc.	Thick- ness Feet	Depth Feet
Sandy clay	6	6
Blue clay	36	42
Sandy clay	17	59
Fine sand	4	63
Coarse sand	23	86

Information upon completion of well:

- (1) Diameter 6" inches.
(2) Total Depth 86 feet.
(3) Water Level 17 feet below top of ground.
(4) Cased to 65', Size 6"
(5) Screen: Size 6", Length 21'
(6) Were there any formations sealed against pollution?
 yes, no no.
If YES depth of formation
Why
Drillers Remarks:

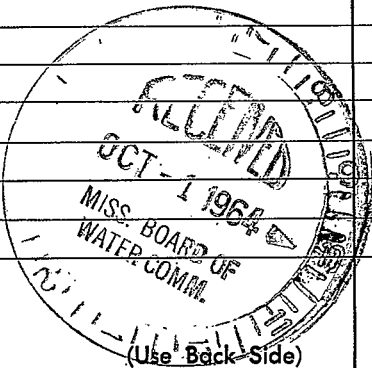

Well No.

