

QUITMAN
E 18
6-7-72

MISSISSIPPI
BOARD OF WATER COMMISSIONERS
416 North State Street
Jackson, Mississippi 39201

CODED

DRAN SLAPER
WATER WELL DRILLERS LOG

6-7-72 date well completed 22 River View firm name Quitman county well located

LANDOWNER: SELF + CO
MARKS, MISS
38646
(mailing address)

description of formations encountered	from	to
Clay	0	15'
fine sand	15'	65'
course sand		
gravel	65'	110'

WELL LOCATION:
sec. 25 T. 28 N. R. 1 E.
1 1/2 miles N.E. of MARKS
(distance) (direction) (nearest town)

WELL PURPOSE: irrigation
(home, irrigation, municipal, industrial)

WELL COMPLETION DATA:

- (1) diameter (inches) 20" hole
- (2) total depth (feet) 110'
- (3) static water level (feet) 15' below top of ground.
- (4) casing 3/4" x 10" 82'-0" (material) (depth)
- if telescope see back. (size)
- (5) screen 28'-0" (length) (depth to top)
10" 3/16" Steel (size) (material)
- (6) pump 30 (HP) 1200 (yield gpm)
unit (type power)
- (7) electric log no (yes or no)
- (organization running log)

CODED

(8) how well bottom plugged Steel plate


13 1972

DRILLERS REMARKS:

MISS. B.L. CF
WATER WELL DRILLERS

If well telescopes please sketch and show depths.

GROUND LEVEL

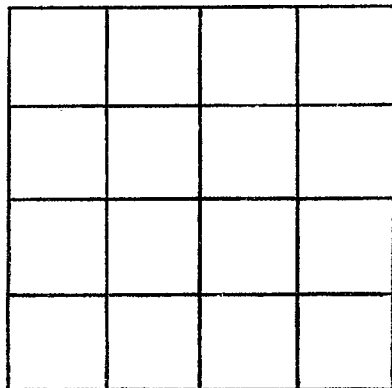

SECTION _____

Please indicate well location X.

ADDITIONAL INFORMATION

If more than one screen,
show locations of each on sketch.