

Quitman  
E 33  
3-10-69

MISSISSIPPI  
 BOARD OF WATER COMMISSIONERS  
 416 North State Street  
 Jackson, Mississippi 39201

**CODED**

WATER WELL DRILLERS LOG

3-10-69 19 J B CRAIN Quitman  
 date well completed firm name county well located

LANDOWNER: Bob Sanders

Marps Miss  
3-10-69  
 (mailing address)

description of formations encountered

from to

<u>Bro Cl</u>	<u>0</u>	<u>30</u>
<u>Sand &amp; G.A.</u>	<u>30</u>	<u>180</u>
<u>Blue Cl</u>	<u>180</u>	<u>350</u>
<u>Sand</u>	<u>350</u>	<u>500</u>
<u>Blue Cl</u>	<u>500</u>	<u>680</u>
<u>Sand</u>	<u>680</u>	<u>920</u>

WELL LOCATION:

sec. 17 T. 28 N. R. 1 E. W  
 S 0  
4 miles NW of Marps  
 (distance) (direction) (nearest town)

WELL PURPOSE:

(home, irrigation, municipal, industrial)

WELL COMPLETION DATA:

- (1) diameter (inches) 4 x 2
- (2) total depth (feet) \_\_\_\_\_
- (3) static water level (feet) Flow below top of ground.
- (4) casing Steel, 920,  
 (material) (depth)  
4x2 if telescope see back.  
 (size)
- (5) screen 30, 890  
 (length) (depth to top)  
2, Stainless S  
 (size) (material)
- (6) pump 1 hp 20  
 (HP) (yield gpm)  
Elect  
 (type power)
- (7) electric log no  
 (yes or no)

**CODED**

(organization running log)

(8) how well bottom plugged Work B


DRILLERS REMARKS:

4 1969

MISS. DEP. OF  
 WATER CONTROL

If well telescopes please sketch and show depths.

GROUND LEVEL

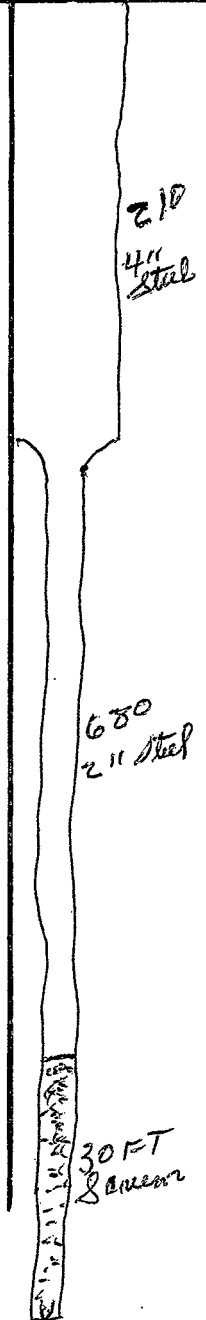

		17 * 16	

SECTION 17

Please indicate well location X.

ADDITIONAL INFORMATION

If more than one screen, show locations of each on sketch.