

E 30100

QUITMAN  
E 35  
9-9-60

WATER WELL DRILLERS LOG CODED

Date: September 9, 1960, Driller: Layne-Central Company County Quitman

(Name)

(1) Owner of Land: Riverside Oil Mill  
(Name)  
Marks, Mississippi  
(Address)  
in mill yard  
(2) Location: S W 1/4, S W 1/4, Sec. 35 T28R1  
\_\_\_\_\_ miles \_\_\_\_\_ of Marks  
(distance) (direction) (Nearest Town)  
(3) Topography: \_\_\_\_\_ level  
(Hilly) (Flat) (Level)  
(4) Purpose of Well: \_\_\_\_\_ industrial  
(Domestic Irrigation  
Municipal, Industrial, Other)

Description & Color of Materials Sand, Clay, Red Clay, Shell, etc.	Thick- ness Feet	Depth Feet
Clay	25	25
Fine sand	5	30
Sand and gravel	4	34
Sand	28	62
Sand and pea gravel	10	72
Sand and gravel	10	82
Coarse sand	16	98
Coarse sand and gravel	14	112


Information upon completion of well:

(1) Diameter: 12 inches.  
(2) Total Depth: 112 feet.  
(3) Water Level: 14' 7" feet below top of ground.  
(4) Cased to 72' 10", Size 12"  
(5) Screen: Size 10", Length 40'  
(6) Were any formations sealed against pollution?  
\_\_\_\_\_ yes, X no.

If YES depth of formation \_\_\_\_\_  
Why \_\_\_\_\_

Drillers Remarks: \_\_\_\_\_

CODED

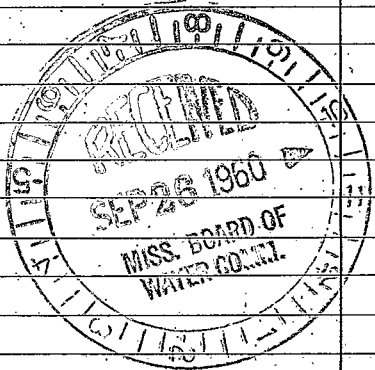

(Use Back Side)

Well No.

