

MISSISSIPPI BOARD OF WATER COMMISSIONERS

QUITMAN
E 38
4-62

WATER WELL DRILLERS LOG

Quitman
CODED
Miss.

Date: April, 1962, Driller: Robert C. Ratliff (Name)

(1) Owner of Land: Clint Mitchell
(Name)
Works, Miss.
(Address)

(2) Location: 1/4, 1/4, Sec. 11 T28R1W
(distance) (direction) (Nearest Town)

(3) Topography: (Hilly) (Flat) (Level)

(4) Purpose of Well: Domestic
(Domestic Irrigation
Municipal, Industrial, Other)

Description & Color of Materials Sand, Clay, Red Clay, Shell, etc.	Thick- ness Feet	Depth Feet
Sand grubs	0	23
Sand gravel	23	68
Gravel	68	120
W. Sand	120	151
Grubs	151	177
Shell	177	308
Sand	308	483
Shell	483	680
Sandy slab streaks	680	910
Grubs	910	963
Rock 1'	963	964
Grubs	964	1000
Rock 1'	1000	1001
Grubs	1001	1060
Sand	1060	1170
Grubs	1170	1323
W. Fine Sand	1323	1394
Sand	1394	1420

Information upon completion of well:

(1) Diameter 3 1/2 inches.

(2) Total Depth 14.70 feet.

(3) Water Level Flowing feet below top of ground.


(4) Cased to 528 of 3", size 927 of 2"

(5) Screen: Size 2", Length 20'

(6) Were any formations sealed against pollution?
_____ yes, no.

If YES depth of formation _____
Why _____

Drillers Remarks: _____

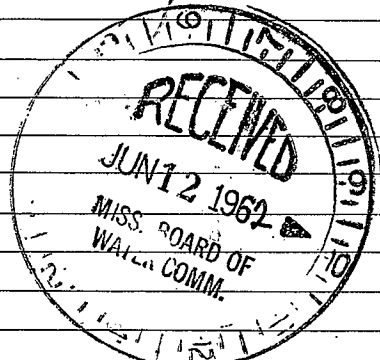

(Use Back Side)

Well No.

