

E39
7-16-57

WATER WELL DRILLERS LOG

11/15/65
270
CODED

Date: July 16, 19 57, Driller: Layne-Central Company County Quitman

(Name)


Graeber Brothers
 (1) Owner of Land: Caledonia Plantation
 (Name)
Marks, Mississippi
 (Address)
 (2) Location: 1/4, 1/4, Sec. 18 T28R14
2 miles northeast, of Belen
 (distance) (direction) (Nearest Town)
 (3) Topography: flat
 (Hilly) (Flat) (Level)
 (4) Purpose of Well: irrigation
 (Domestic Irrigation
 Municipal, Industrial, Other)

Description & Color of Materials Sand, Clay, Red Clay, Shell, etc.	Thick- ness Feet	Depth Feet
Clay	12	12
Fine sand	12	24
Coarse sand	34	58
Coarse sand, small gravel	35	93
Coarse sand, big gravel	15	108

CODED

Information upon completion of well:

(1) Diameter 18x16 inches.
 (2) Total Depth 1108" feet.
 (3) Water Level 13'-3" feet below top of ground.
 (4) Cased to 56', Size 18"
2' swage
 (5) Screen: Size 16", Length 50'
 (6) Were any formations sealed against pollution?
no yes, no no.
 If YES depth of formation _____
 Why _____
 Drillers Remarks: _____
1200 GPM
engine drive

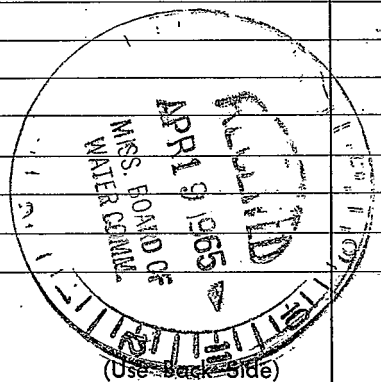

Well No.

...the ... of ...

...the ... of ...

