

MISSISSIPPI  
BOARD OF WATER COMMISSIONERS  
416 North State Street  
Jackson, Mississippi 39201

CODED

WATER WELL DRILLERS LOG

Quitman  
E40  
4-8-74

April 8, 1974 Singer-Layne Central Div. Quitman  
date well completed firm name county well located


LANDOWNER:	description of formations encountered	from	to
Self & Company			
Marks, Ms. (mailing address)	Clay	0	25
	Coarse Sand	25	40
	Pea Gravel	40	50
WELL LOCATION: sec. 2 T <sup>28</sup> N R <sup>10</sup> W	Coarse Sand	50	80
	Gravel Sand	80	96
_____ miles West of Essex, Ms. (distance) (direction) (nearest town)			
WELL PURPOSE: Irrigation (home, irrigation, municipal, industrial)			
WELL COMPLETION DATA:			
(1) diameter (inches) 16"			
(2) total depth (feet) 96'			
(3) static water level (feet) 13 below top of ground.			
(4) casing Steel 46' (material) (depth)			
16" if telescope see back. (size)			
(5) screen 50' 96' (length) (depth to top)			
16" Armco Iron (size) (material)			
(6) pump 50 2400 (HP) (yield gpm)			
Electric (type power)			
(7) electric log No (yes or no)			
(organization running log)			
(8) how well bottom plugged Plate			
DRILLERS REMARKS:			

CODED

DRILLER  
MAY 1974  
MISS. Bd. of Water Comm.

If well telescopes please sketch and show depths.

GROUND LEVEL

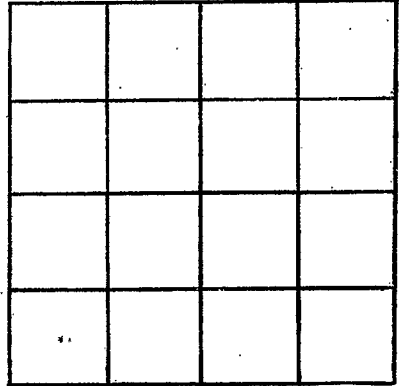

SECTION \_\_\_\_\_

Please indicate well location X.

ADDITIONAL INFORMATION

If more than one screen, show locations of each on sketch.