

Quitman  
E 44  
A-8-74

MISSISSIPPI  
 BOARD OF WATER COMMISSIONERS  
 416 North State Street  
 Jackson, Mississippi 39201  
**WATER WELL DRILLERS LOG**

**CODED**

April 8, 1974 Singer-Layne Central Div. Quitman  
 date well completed firm name county well located


LANDOWNER:	description of formations encountered	from	to
Self & Company			
Marks, Ms. (mailing address)	Clay	0	21
	Fine Sand	21	40
	Pea Gravel	40	60
<b>WELL LOCATION:</b> sec. 2 T 28 N R 10 E W	Coarse Sand & big gravel	60	80
	Coarse Sand	80	85
	Gravel Sand	85	106
_____ miles West of Essex, Ms (distance) (direction) (nearest town)			
<b>WELL PURPOSE:</b> Irrigation (home, irrigation, municipal, industrial)			
<b>WELL COMPLETION DATA:</b>			
(1) diameter (inches) 16"			
(2) total depth (feet) 106'			
(3) static water level (feet) 13 below above top of ground.			
(4) casing Steel, 56' (material) (depth) 16" if telescope see back. (size)			
(5) screen 50', 106' (length) (depth to top) 16" Armco Iron (size) (material)			
(6) pump 50 2400 (HP) (yield gpm) Electric (type power)			
(7) electric log No (yes or no) (organization running log)			
(8) how well bottom plugged Plate			
<b>DRILLERS REMARKS:</b>			

**CODED**

DEPT. OF AGRICULTURE  
 MISS. DIV. OF WATER RESOURCES  
 APR 10 1974  
 MISS. DIV. OF WATER RESOURCES

If well telescopes please sketch and show depths.

GROUND LEVEL

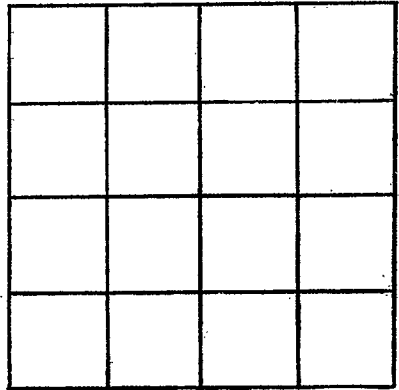

SECTION \_\_\_\_\_

Please indicate well location X.

ADDITIONAL INFORMATION

If more than one screen, show locations of each on sketch.