

*Quitman*  
 CL-2120 *RE 49*  
 615182

MISSISSIPPI  
 BOARD OF WATER COMMISSIONERS  
 416 North State Street  
 Jackson, Mississippi 39201

CODED

WATER WELL DRILLERS LOG

6-5-1982 LAYNE CENTRAL CO. QUITMAN  
 date well completed firm name county well located

LANDOWNER:	description of formations encountered	from	to
CIRCLE "S" IRRIGATION @ Self & Co. Farms Marks, MS (mailing address)			
WELL LOCATION: sec. 2 T. 28 N. R. 1 W 2 miles S. of Darling (distance) (direction) (nearest town)	sand	18	30
WELL PURPOSE: (home irrigation, municipal, industrial)	med. coarse sand	30	43
WELL COMPLETION DATA: (1) diameter (inches) 32"	c. sand & pea gravel	43	78
(2) total depth (feet) 119'	c. sand & gravel	78	119
(3) static water level (feet) 15' below top of ground.			
(4) casing steel 69' (material) (depth) 16" (size) if telescope see back.			
(5) screen 50' 69' (length) (depth to top) 16" st. steel (size) (material)			
(6) pump 125 1800 (HP) (yield gpm) gear drive (type power)			
(7) electric log no (yes or no) (organization running log)			
(8) how well bottom plugged st. plate			
DRILLERS REMARKS:			


DEPT. OF NATURAL RESOURCES  
 BUREAU OF LAND & WATER RESOURCES

JUN 24 1982

RECEIVED

If well telescopes please sketch and show depths.

GROUND LEVEL

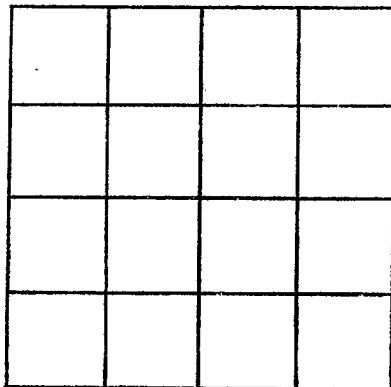

SECTION \_\_\_\_\_

Please indicate well location X.

ADDITIONAL INFORMATION

A series of horizontal lines for recording additional information, starting below the 'ADDITIONAL INFORMATION' header and extending to the bottom of the page.

If more than one screen, show locations of each on sketch.