

QUITMAN
 22-3277 E 52
 WELL #2
7358

Code

MISSISSIPPI DEPARTMENT OF NATURAL RESOURCES
 Bureau of Land and Water Resources
 Southport Mall
 P.O. Box 10631
 Jackson, Mississippi 39209
WATER WELL DRILLERS LOG

7-30- 19 86 LAYNE-CENTRAL CO. QUITMAN
 date well completed firm name county well located


LANDOWNER:	description of formations encountered	from	to
CITY OF MARKS			
MARKS, MS (mailing address)	CLAY	0	18
WELL LOCATION: WELL #2	COARSE SAND & PEA GR.	18	146
sec. <u>35-T-28-N</u> R <u>1-E</u> W	SAND	146	214
ON PANG STREET	CLAY	214	305
(distance) miles (direction) of (nearest town)	FINE SAND & STKS. OF CLAY	305	371
WELL PURPOSE: MUNICIPAL (home, irrigation, municipal, industrial)	CLAY	371	377
WELL COMPLETION DATA:	STKS. OF SAND W/ SHALE	377	391
(1) diameter (inches) <u>12"</u>	SANDY SHALE	391	398
(2) total depth (feet) <u>875'</u>	ROCK	398	399
(3) static water level (feet) <u>FLOWING</u> below above top of ground.	SHALE	399	420
(4) casing <u>STEEL</u> <u>818</u> (material) (depth)	ROCK	420	421
<u>12"</u> (size) if telescope see back.	SANDY SHALE	421	463
(5) screen <u>50'9"</u> <u>818'</u> (length) (depth to top)	STKS. OF FINE SAND W/ CLAY	463	502
<u>12"</u> <u>ST. STEE.</u> (size) (material)	SANDY SHALE	502	547
(6) pump <u>20</u> <u>500</u> (HP) (yield gpm)	ROCK	547	548
<u>ELECTRIC</u> (type power)	CLAY	548	574
(7) electric log <u>YES</u> (yes or no)	SANDY SHALE	574	587
<u>U.S.G.S.</u> (organization running log)	SANDY CLAY	587	593
(8) how well bottom plugged <u>4" BP VALVE</u>	SANDY SHALE	593	614
DRILLERS REMARKS:	CLAY	614	638
	STKS. OF SAND & SHALE	638	662
	CLAY	662	685
	STKS. OF SAND & SHALE	685	748
	FINE SAND	748	769
	STKS. OF SAND & SHALE	769	778
	SAND	778	798
	SANDY SHALE	798	810
	STKS. OF SAND W/ CLAY	810	823
	SAND	823	874
	CLAY	874	886

FFR 4 1988

Department of Natural Resources
 Bureau of Land & Water Resources

If well telescopes please
sketch and show depths.

GROUND LEVEL

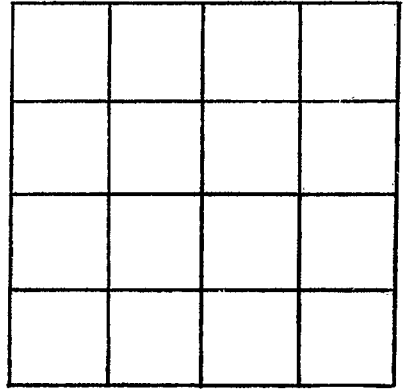

SECTION _____

Please indicate well location X.

ADDITIONAL INFORMATION

If more than one screen,
show locations of each on sketch.