

MISSISSIPPI DEPARTMENT OF NATURAL RESOURCES

Bureau of Land and Water Resources

Southport Mall

CODED

P.O. Box 10631

Jackson, Mississippi 39209

WATER WELL DRILLERS LOG

Quitman  
COAHOMA

Quitman  
COAHOMA

E65  
F 0001  
COAHOMA  
3-20-85

GW03516

RP  
11/05

3-20 1985  
date well completed

Power IRR  
firm name

Quitman  
COAHOMA  
county well located

LANDOWNER:  
James Fortner  
MARKS, M.S.  
(mailing address)

description of formations encountered	from	to
Clay	0	30
Clay + Coarse Sand	30	40
Coarse Sand + Gravel	40	93

WELL LOCATION: ~~92-100-?~~  
sec. ~~7~~ T ~~27~~ N R ~~10~~ E  
4 miles S-EAST of DARNING  
(distance) (direction) (nearest town)

CODED

WELL PURPOSE: Irrigation  
(home, irrigation, municipal, industrial)

- WELL COMPLETION DATA:
- (1) diameter (inches) 12
  - (2) total depth (feet) 93
  - (3) static water level (feet) 16 below above top of ground.
  - (4) casing Steel, 53 (material), (depth)  
12 (size) if telescope see back.
  - (5) screen 40, 53 (length), (depth to top)  
12 (size), Steel (material)
  - (6) pump 40 (HP), 1500 (yield gpm)  
Diesel (type power)
  - (7) electric log NO (yes or no)  
(organization running log)
  - (8) how well bottom plugged Steel  
Plate


RECEIVED  
APR 22 1985

DRILLERS REMARKS:

Department of Natural Resources  
Bureau of Land & Water Resources

If well telescopes please sketch and show depths.

GROUND LEVEL

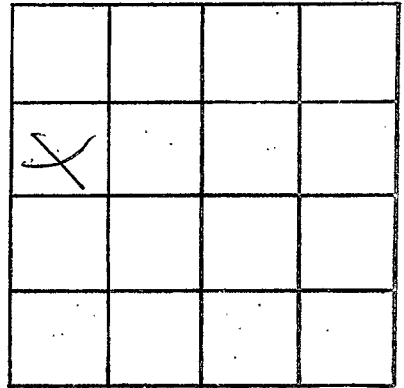

SECTION 4

Please indicate well location X.

ADDITIONAL INFORMATION

If more than one screen,  
show locations of each on sketch.