

QUITMAN
E 2000
4-21-76

MISSISSIPPI
BOARD OF WATER COMMISSIONERS
416 North State Street
Jackson, Mississippi 39201

WATER WELL DRILLERS LOG

4-21-76 19
date well completed

J B Cain
Drill name

Quitman
county well located

LANDOWNER Mr Ford

description of formations encountered

from to

Marker ms

Gumbo

0 25

Hwy 3 North
(mailing address)

Sand

25 50

WELL LOCATION:

sec. 14 T 28 N ✓ R 10 E ✓
S W ✓
3 miles N of Marks
(distance) (direction) (nearest town)

WELL PURPOSE: Farm Use
(home, irrigation, municipal, industrial)

WELL COMPLETION DATA:

- (1) diameter (inches) 2"
- (2) total depth (feet) 50
- (3) static water level (feet) 10 below above
top of ground.
- (4) casing Plastic 50
(material) (depth)
(size) if telescope see back.
- (5) screen 10' 40
(length) (depth to top)
4" Plastic
(size) (material)
- (6) pump 3 25
(HP) (yield gpm)
Gas Engine
(type power)
- (7) electric log NO
(yes or no)

(organization running log)

(8) how well bottom plugged Plug


DRILLERS REMARKS:

REGISTERED
APR 27 1976

MISS. Bd. OF WATER

If well telescopes please sketch and show depths.

GROUND LEVEL

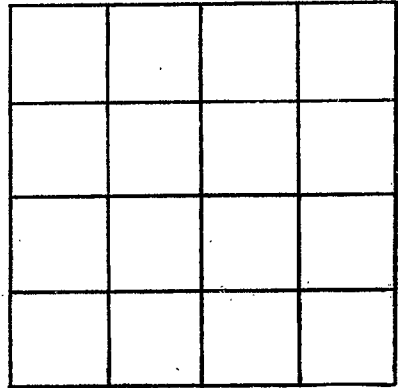

SECTION _____

Please indicate well location X.

ADDITIONAL INFORMATION

If more than one screen, show locations of each on sketch.