

Quitman
E
2001
11-2-79

MISSISSIPPI
 BOARD OF WATER COMMISSIONERS
 416 North State Street
 Jackson, Mississippi 39201

WATER WELL DRILLERS LOG

11-2 1979 Fire Co. Forman Dam Quitman
 date well completed firm name county well located

LANDOWNER: <u>James R. Aldridge</u>	description of formations encountered	from	to
<u>BT-2 Box 166</u>	<u>top soil</u>	<u>0</u>	<u>10</u>
<u>Mark Min</u> (mailing address)	<u>fine sand</u>	<u>10</u>	<u>22</u>
WELL LOCATION: sec <u>33</u> T <u>25</u> N R <u>1</u> E <u>1</u> miles <u>W</u> of <u>Mark</u> (distance) (direction) (nearest town)	<u>Coarse Brown sand</u>	<u>22</u>	<u>32</u>
WELL PURPOSE: (home, irrigation, municipal, industrial)			
WELL COMPLETION DATA:			
(1) diameter (inches) <u>2"</u>			
(2) total depth (feet) <u>32'</u>			
(3) static water level (feet) <u>12</u> ^{below} / _{above}			
(4) casing <u>Galv</u> <u>26</u> (material) (depth)			
_____ If telescope see back. (size)			
(5) screen <u>6'</u> <u>28'</u> (length) (depth to top)			
<u>2"</u> <u>stainless steel</u> (size) (material)			
(6) pump <u>1/2</u> <u>8</u> (HP) (yield gpm)			
<u>Electric</u> (type power)			
(7) electric log <u>no</u> (yes or no)			
_____ (organization running log)			
(8) how well bottom plugged <u>point</u>			
DRILLERS REMARKS:			


DEPT. OF NATURAL RESOURCES
 BUREAU OF LAND & WATER RESOURCES

NOV 19 1979

RECEIVED

If well telescopes please sketch and show depths.

GROUND LEVEL

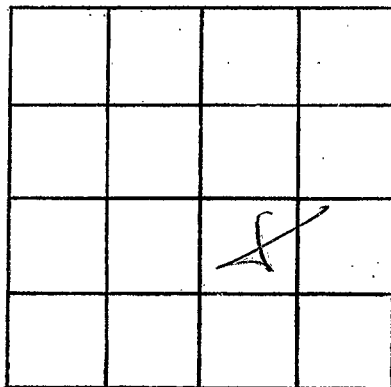

SECTION _____

Please indicate well location X.

ADDITIONAL INFORMATION

If more than one screen,
show locations of each on sketch.