

MISSISSIPPI DEPARTMENT OF NATURAL RESOURCES

Bureau of Land and Water Resources

P.O. Box 10631

Jackson, Mississippi 39209

WATER WELL DRILLERS LOG

COUNTY WELL LOCATED
Quitman

WELL NUMBER *E* CODED

DATE WELL COMPLETED
2003 5-18-90

PERMIT NUMBER

NAME OF DRILLING FIRM
Towell Brothers

Clarksdale, Miss

NAME & MAILING ADDRESS OF LANDOWNER
Jimmy Fortner
Rt 2 Box 93
marks, miss 38646

WELL LOCATION: SEC *4* TOWNSHIP *28 N* RANGE *10 W*

DISTANCE *4* Miles DIRECTION *SE* of NEAREST TOWN *DARLING*

OTHER LANDMARK

WELL PURPOSE: Home, Irrigation, Municipal, Industrial, Fish Pond, etc.

PUMP DATA

PUMP TYPE (Circle One):
Submersible, Turbine, Jet, Flowing Well,
Other (Describe)

POWER TYPE (Circle One):
Electric, Tractor, Diesel, Gasoline, Butane,
Other (Describe) H/P

Pump Capacity (GPM) No. of Stages Setting Depth
1500-2000 2 50 FT.

PUMP TEST

Well yielded _____ GPM with
a drawdown of _____ ft.
after _____ hours of pumping

WELL DATA

Well Depth *100* Casing Diameter (In.) *12* Casing Length (Ft.) *60*

Type of Casing *Steel* Hole Depth *100* Depth to Static Water Level *14'*

TYPE OF COMPLETION: (Circle One or More):
Gravel Packed, Underreamed, Telescoped,
Natural Development, Open Hole, Other

Top of Lap Pipe or Reduction in Casing

FEET IF TELESCOPED OR MORE THAN ONE SCREEN: USE BACK PAGE

LOG DATA

TYPE OF LOG RUN (Circle One): No Log Run,
Electric, Gamma Ray, Density, Sonic, Neutron,
Other (Describe)

Name of Organization Running Log

SCREEN DATA

Diameter - Inches *12* Length - Feet *40* Slot Size - Inches *.040*

Screen Type *Steel* Depth to Bottom - Feet *100*

GEOLOGIC DATA (Office Use Only)

Surface Elev.	Geologic Unit	Unit Thickness	Depth to Top
Subs. SWL	Date	Analysis	Aquifer Test


Driller's Remarks

DESCRIPTION OF FORMATIONS ENCOUNTERED	FROM	TO	FORMATIONS (Continued)	FROM	TO
<i>Top soil</i>	<i>0</i>	<i>10</i>	RECEIVED OCT 05 1990 Department of Natural Resources Bureau of Land & Water Resources		
<i>Clay</i>	<i>10</i>	<i>20</i>			
<i>Clay</i>	<i>20</i>	<i>30</i>			
<i>fine sand</i>	<i>30</i>	<i>40</i>			
<i>Coarse sand</i>	<i>40</i>	<i>90</i>			
<i>Heavy gravel</i>	<i>90</i>	<i>100</i>			

IF MORE SPACE IS NEEDED, USE BACK

If well telescopes please
sketch and show depths.

GROUND LEVEL

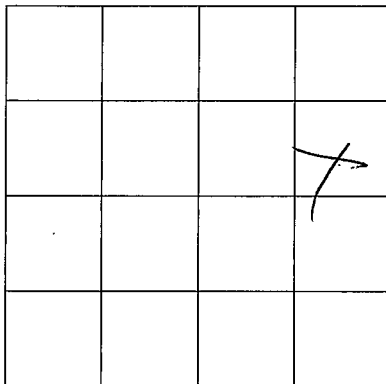

SECTION 4

Please indicate well location X.

ADDITIONAL INFORMATION

If more than one screen,
show location of each on sketch.