

MISSISSIPPI DEPARTMENT OF NATURAL RESOURCES

Bureau of Land and Water Resources

P.O. Box 10631

Jackson, Mississippi 39209

WATER WELL DRILLERS LOG

COUNTY WELL LOCATED Quitman	
WELL NUMBER E	CODED
2005	
DATE WELL COMPLETED 3-18-94	

PERMIT NUMBER
NAME OF DRILLING FIRM Houston

NAME & MAILING ADDRESS OF LANDOWNER Jimmy Fortner			
WELL LOCATION:	SEC	TOWNSHIP	RANGE
Darling	6	28	N 7 E
DISTANCE	DIRECTION	NEAREST TOWN	
Miles _____ of _____			
OTHER LANDMARK			
WELL PURPOSE: Home, Irrigation, Municipal, Industrial, Fish Pond, etc. Irrigation			

PUMP DATA		
PUMP TYPE (Circle One): Submersible, Turbine , Jet, Flowing Well, Other (Describe) _____		
POWER TYPE (Circle One): Electric, Tractor, Diesel, Gasoline, Butane, Other (Describe) _____ H/P _____		
Pump Capacity (GPM) 1500	No. of Stages 2	Setting Depth 50 FT.
PUMP TEST		
Well yielded 1500 GPM with a drawdown of _____ ft. after _____ hours of pumping		

WELL DATA		
Well Depth 110'	Casing Diameter (In.) 12"	Casing Length (Ft.) 70'
Type of Casing Steel	Hole Depth 110'	Depth to Static Water Level
TYPE OF COMPLETION: (Circle One or More): Gravel Packed , Underreamed, Telescoped, Natural Development, Open Hole, Other (Describe) _____		
Top of Lap Pipe or Reduction in Casing		
FEET	IF TELESCOPED OR MORE THAN ONE SCREEN: USE BACK PAGE	

LOG DATA	
TYPE OF LOG RUN (Circle One): Electric, Gamma Ray, Density, Sonic, Neutron, Other (Describe) _____	
Name of Organization Running Log	

SCREEN DATA		
Diameter - Inches 12"	Length - Feet 40'	Slot Size - Inches
Screen Type Wire wrapped	Depth to Bottom - Feet	


GEOLOGIC DATA (Office Use Only)			
Surface Elev.	Geologic Unit	Unit Thickness	Depth to Top
Subs. SWL	Date	Analysis	Aquifer Test
Driller's Remarks AUG 11 1994			
Dept. of Environmental Quality Office of Land & Water Resources			

DESCRIPTION OF FORMATIONS ENCOUNTERED	FROM	TO
Clay	0	10
Clay	10	20
Clay & F. Sand	20	30
F. & M. Sand	30	40
M. Sand & gravel	40	50
Gravel	50	60
Gravel	60	70
Gravel	70	80
Gravel	80	90
Gravel	90	100
Gravel	100	110

FORMATIONS (Continued)	FROM	TO

IF MORE SPACE IS NEEDED, USE BACK

escopes please
d show depths.

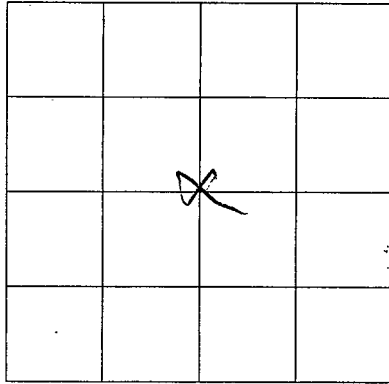

SECTION _____

Please indicate well location X.

ADDITIONAL INFORMATION

ne screen,
of each on sketch.