

Quitman
 F5
 9-68

MISSISSIPPI
 BOARD OF WATER COMMISSIONERS
 416 North State Street
 Jackson, Mississippi 39201

CODED

WATER WELL DRILLERS LOG

~~9-11-68~~

Quitman
 county well located

19 date well completed

firm name

county well located

LANDOWNER

Mr Ducey

description of formations
 encountered

from to

Jones
Marks
 (mailing address)

Bro of
Sandstone
Blue of
Sand
Blue of
Sand

0 20
20 200
200 280
280 350
350 450
450 487

WELL LOCATION:

sec. 20 T. 28 N. R. 1 E. S. 1
6 miles E of Marks
 (distance) (direction) (nearest town)

WELL PURPOSE:

(home, irrigation, municipal, industrial)

WELL COMPLETION DATA:

- (1) diameter (inches) 2"
- (2) total depth (feet) 487
- (3) static water level (feet) Flow below top of ground. 20 *Set Per Minute*
- (4) casing Solignum 487
 (material) (depth)

CPD

2 if telescope see back.
 (size)

(5) screen Perforated Pipe 40 FT
 (length) (depth to top)

CODED

2 Solignum
 (size) (material)


(6) pump 70 20
 (HP) (yield gpm)

(type power)

(7) electric log no
 (yes or no)

(organization running log)

(8) how well bottom plugged Wash
Bottom

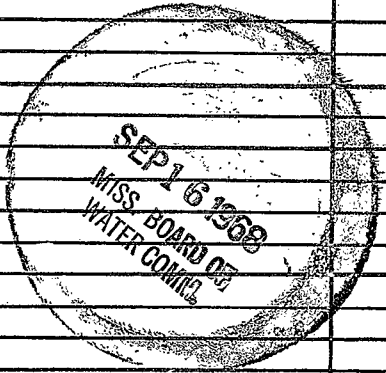

DRILLERS REMARKS:

6 Miles
Cost of Marks on
High 6 Do Not
Have map for this county

If well telescopes please sketch and show depths.

GROUND LEVEL

SECTION _____

Please indicate well location X.

ADDITIONAL INFORMATION

If more than one screen,
show locations of each on sketch.