

CODED

F 6
9-65

WATER WELL DRILLERS LOG

Date: , 1965, Driller: Jimmy Roberson County Paula
(Name)

(1) Owner of Land: Mr. James Reed
(Name)

4 Marks
(Address)

(2) Location: 1/4, 1/4, Sec. 28 T28R1E,
8 miles N.E. of Marks,
(distance) (direction) (Nearest Town)

(3) Topography:
(Hilly) (Flat) (Level)

(4) Purpose of Well: Home
(Domestic Irrigation
Municipal, Industrial, Other)

Description & Color of Materials Sand, Clay, Red Clay, Shell, etc.	Thick- ness Feet	Depth Feet
<u>Sand</u>	<u>0</u>	<u>100</u>
<u>Clay</u>	<u>100</u>	<u>200</u>
<u>Sand</u>	<u>300</u>	<u>380</u>
<u>Sand</u>	<u>380</u>	<u>500</u>

Information upon completion of well:

(1) Diameter 2 inches.

(2) Total Depth 500 feet.

(3) Water Level flowing feet below top of ground.

(4) Cased to 400, Size 2 in

(5) Screen: Size Open, Length Bottom


(6) Were any formations sealed against pollution?
 yes, no.

If YES depth of formation

Why

Drillers Remarks: Steel well

CODED

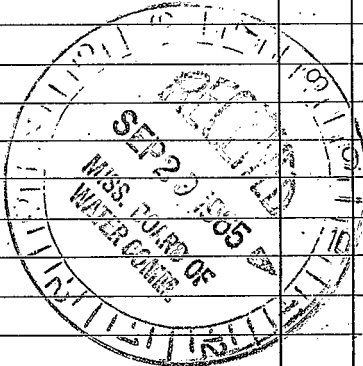

(Use Back Side)

Well No.

