

F 1
 Quitman
 4/16/75

MISSISSIPPI
 BOARD OF WATER COMMISSIONERS
 416 North State Street
 Jackson, Mississippi 39201

CODED

WATER WELL DRILLERS LOG

April 16 1975 North Miss-Well Drill - Quitman
 date well completed firm name county well located

LANDOWNER: <u>Mr. H.T. Pitman</u> <u>MARKS</u>	description of formations encountered	from	to
(mailing address)	<u>Clay</u>	<u>0</u>	<u>20</u>
WELL LOCATION: sec. <u>21</u> T. <u>28</u> N ✓ R. <u>1</u> E ✓ S W	<u>Sand</u>	<u>20</u>	<u>65</u>
4 miles <u>N-E</u> of <u>MARKS</u> (distance) (direction) (nearest town)			
WELL PURPOSE: <u>House</u> (home, irrigation, municipal, industrial)			
WELL COMPLETION DATA:			
(1) diameter (inches) <u>2"</u>			
(2) total depth (feet) <u>65'</u>			
(3) static water level (feet) <u>10</u> below top of ground.			
(4) casing <u>PLASTIC</u> , <u>65'</u> (material) (depth)			
_____ if telescope see back. (size)			
(5) screen <u>5'</u> , <u>60</u> (length) (depth to top)			
<u>2"</u> , <u>PLASTIC</u> (size) (material)			
(6) pump <u>✓</u> <u>✓</u> (HP) (yield gpm)			
<u>✓</u> (type power)			
(7) electric log <u>No</u> (yes or no)			
_____ (organization running log)			
(8) how well bottom plugged <u>Plug</u>			
DRILLERS REMARKS:			


RECEIVED

MAY 27 1975

MISS. BD. OF WATER COMMISSIONERS

If well telescopes please sketch and show depths.

GROUND LEVEL

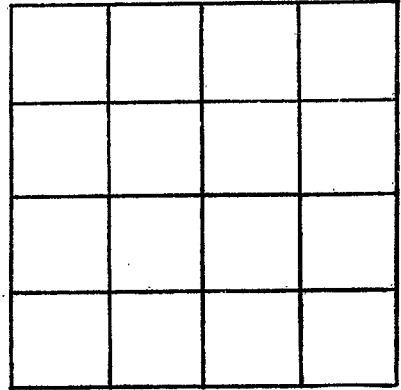

SECTION _____

Please indicate well location X.

ADDITIONAL INFORMATION

If more than one screen, show locations of each on sketch.