

#2

CODED

QUITMAN
F 8
3-1-76

MISSISSIPPI
BOARD OF WATER COMMISSIONERS
416 North State Street
Jackson, Mississippi 39201

WATER WELL DRILLERS LOG

March 1 1976 North Miss Well Drilling Quitman
date well completed firm name county well located

LANDOWNER: <u>Quitman</u>	description of formations encountered	from	to
(mailing address)	<u>Clay</u>	<u>0</u>	<u>12</u>
WELL LOCATION: sec. <u>32</u> T <u>28</u> N L R <u>1</u> E W <u>3</u> miles <u>E</u> of <u>Marke</u> (distance) (direction) (nearest town)	<u>Sand</u>	<u>13</u>	<u>63</u>
WELL PURPOSE: <u>Irrigation</u> (home, irrigation, municipal, industrial)	<u>Red Shale & Sand</u>	<u>53</u>	<u>90</u>
WELL COMPLETION DATA:			
(1) diameter (inches) <u>4"</u>			
(2) total depth (feet) <u>90</u>			
(3) static water level (feet) <u>90</u> below top of ground.			
(4) casing <u>Plastic</u> , <u>90</u> (material) (depth)			
(5) screen <u>50</u> <u>40</u> (size) (length) (depth to top)			
(6) pump <u>Cent</u> <u>1200</u> (HP) (yield gpm) <u>Motor Belt Driven</u> (type power)			
(7) electric log <u>no</u> (yes or no)			
(8) how well bottom plugged <u>Plug</u>			
DRILLERS REMARKS:			


CODED

RECEIVED

APR 20 1976

If well telescopes please
sketch and show depths.

GROUND LEVEL

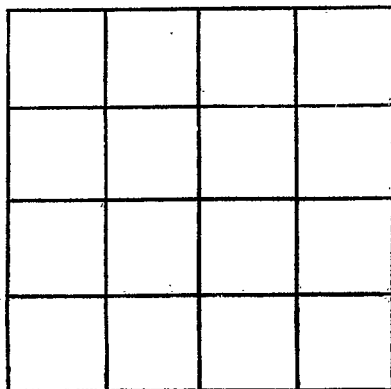

SECTION _____

Please indicate well location X.

ADDITIONAL INFORMATION

If more than one screen,
show locations of each on sketch.