


QUITMAN
~~1/19~~
4-21-76

MISSISSIPPI
 BOARD OF WATER COMMISSIONERS
 416 North State Street
 Jackson, Mississippi 39201 CODED
 WATER WELL DRILLERS LOG

April 21, 19 76 Layne Central Company Quitman
 date well completed firm name county well located

LANDOWNER: Self & Co. Marks, Miss. (mailing address)	description of formations encountered	from	to
	Clay	0	10'
	Fine Sand	10	30'
	Coarse Sand	30	40'
	Coarse Sand & Gravel	40	112'
WELL LOCATION: sec <u>7</u> T <u>28</u> N R <u>1</u> E W S 3 miles East of Hinchcliff (distance) (direction) (nearest town)			
WELL PURPOSE: irrigation (home, irrigation, municipal, industrial)			
WELL COMPLETION DATA: (1) diameter (inches) <u>16"</u> (2) total depth (feet) <u>112'</u> (3) static water level (feet) <u>12</u> below top of ground above (4) casing <u>Steel</u> <u>62'</u> (material) (depth) <u>16"</u> if telescope see back. (size) (5) screen <u>50'</u> <u>62'</u> (length) (depth to top) <u>16"</u> <u>Steel</u> (size) (material) (6) pump <u>60</u> <u>2800-3000</u> (HP) (yield gpm) <u>Engine</u> (type power) (7) electric log <u>no</u> (yes or no) <u>(organization running log)</u> (8) how well bottom plugged <u>steel plate</u>			
DRILLERS REMARKS:			

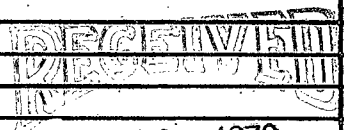

MAY 20 1976
 MISSISSIPPI

MISS. BD. OF WATER COMMISSIONERS

If well telescopes please sketch and show depths.

GROUND LEVEL

SECTION _____

Please indicate well location X.

ADDITIONAL INFORMATION

If more than one screen, show locations of each on sketch.