

#1

Quitman
M 34 F-10
2-15-76

MISSISSIPPI
BOARD OF WATER COMMISSIONERS
416 North State Street
Jackson, Mississippi 39201

CODED

WATER WELL DRILLERS LOG

Feb 15 1976 North miss Well Drilling Quitman
date well completed firm name County well located

LANDOWNER: Pitman
Markes
(mailing address)

description of formations encountered	from	to
Clay	0	15
Sand	15	60
Red Shale	60	90
Sand		


WELL LOCATION:
sec. 32 T 28 N R 1 E W
3 miles E of Markes
(distance) (direction) (nearest town)

CODED

WELL PURPOSE: Irrigation
(home, irrigation, municipal, industrial)

- WELL COMPLETION DATA:
- (1) diameter (inches) 8"
 - (2) total depth (feet) 90
 - (3) static water level (feet) 9 below above top of ground.
 - (4) casing Plastic, 90, (material) (depth)
 - (5) screen 50' 40' (length) (depth to top)
8" Slot Plastic (size) (material)
 - (6) pump Cent-1200 (HP) (yield gpm)
Meter Belt Driven (type power)
 - (7) electric log No (yes or no)
 - (8) how well bottom plugged Plug


DRILLERS REMARKS:

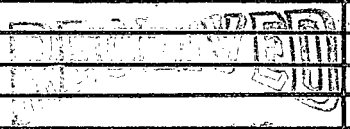

APR 20 1976

If well telescopes please
sketch and show depths.

GROUND LEVEL

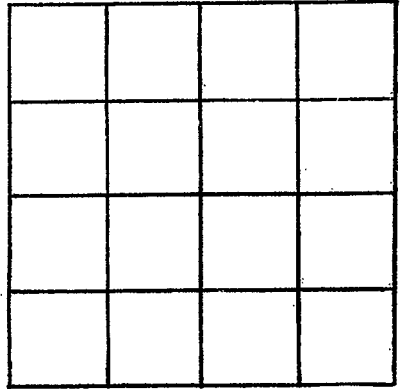

SECTION _____

Please indicate well location X.

ADDITIONAL INFORMATION

If more than one screen,
show locations of each on sketch.