

MISSISSIPPI DEPARTMENT OF NATURAL RESOURCES

Bureau of Land and Water Resources

Southport Mall

P.O. Box 10631

Jackson, Mississippi 39209

WATER WELL DRILLERS LOG

CODED

Quitman
F 13
4/12/82

4-12-82 19

POWER FABRICATION

Quitman

date well completed

firm name

county well located

LANDOWNER:	description of formations encountered	from	to
JACK BUTLER			
MARKS MISS (mailing address)	CLAY	0	13
	FINE SAND	13	23
	BLUE CLAY	23	63
	COARSE SAND + GRAVEL	63	113
WELL LOCATION:			
sec. 29 T 21 N S R 1 E W			
3 miles NE of MARKS (distance) (direction) (nearest town)			
WELL PURPOSE: (home, irrigation, municipal, industrial)			
WELL COMPLETION DATA:			
(1) diameter (inches) 16			
(2) total depth (feet) 113			
(3) static water level (feet) 12 below top of ground.			
(4) casing 16 (material), 23 (depth), (size) if telescope see back.			
(5) screen 16" (length), 23 (depth to top) 16" (size), steel (material)			
(6) pump 60 (HP), 3000 (yield gpm) Diesel (type power)			
(7) electric log no (yes or no) (organization running log)			
(8) how well bottom plugged steel pipe			
DRILLERS REMARKS:			


DEPT. OF NATURAL RESOURCES
BUREAU OF LAND & WATER RESOURCES

JUN - 4 1982

RECEIVED

If well telescopes please sketch and show depths.

GROUND LEVEL

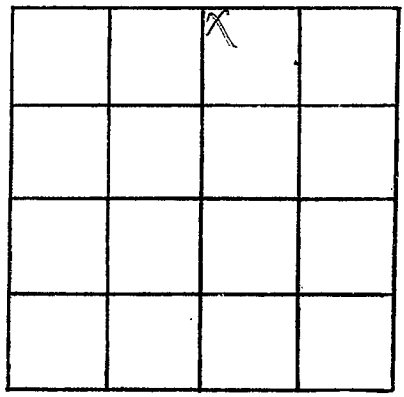

SECTION 29

Please indicate well location X.

ADDITIONAL INFORMATION

Lined area for additional information.

If more than one screen, show locations of each on sketch.