

MISSISSIPPI DEPARTMENT OF NATURAL RESOURCES

Bureau of Land and Water Resources

Southport Mall

P.O. Box 10631

Jackson, Mississippi 39209

CODED

WATER WELL DRILLERS LOG

Quitman
F 14
4/12/82

21-12-82 19 Power Irrigation Quitman
 date well completed firm name county well located

LANDOWNER:	description of formations encountered	from	to
<u>JACK BUTLER</u>			
<u>MARKS MISS</u> (mailing address)	<u>top soil & clay</u>	<u>0</u>	<u>13</u>
	<u>fine brown silt</u>	<u>13</u>	<u>29</u>
	<u>med. sand</u>	<u>33</u>	<u>53</u>
	<u>gravel sand</u>	<u>53</u>	<u>113</u>
WELL LOCATION:			
sec. <u>29</u> T <u>28</u> N R <u>1</u> E S W			
<u>3</u> miles <u>NE</u> of <u>MARKS</u> (distance) (direction) (nearest town)			
WELL PURPOSE: (home, irrigation, municipal, industrial)			
WELL COMPLETION DATA:			
(1) diameter (inches) <u>16</u>			
(2) total depth (feet) <u>113</u>			
(3) static water level (feet) <u>12</u> below top of ground.			
(4) casing <u>steel</u> , <u>23</u> (material) (depth)			
<u> </u> if telescope see back. (size)			
(5) screen <u>40</u> , <u>23</u> (length) (depth to top)			
<u>16</u> , <u>steel</u> (size) (material)			
(6) pump <u>60</u> , <u>2000</u> (HP) (yield gpm)			
<u>Diesel</u> (type power)			
(7) electric log <u>NO</u> (yes or no)			
<u> </u> (organization running log)			
(8) how well bottom plugged <u>steel pipe</u>			
DRILLERS REMARKS:			


DEPT. OF NATURAL RESOURCES
 BUREAU OF LAND & WATER RESOURCES

JUN - 4 1982

RECEIVED

If well telescopes please sketch and show depths.

GROUND LEVEL

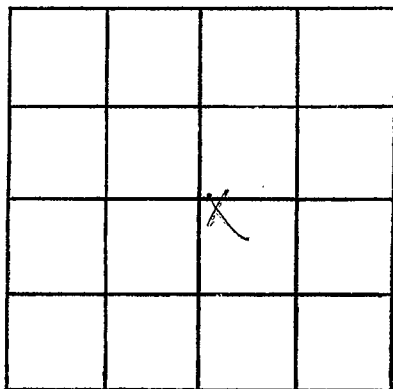

SECTION 29

Please indicate well location X.

ADDITIONAL INFORMATION

If more than one screen,
show locations of each on sketch.